

WATER SERVICE RECORD

Name

Service No.

Address

254 Bedford Street

Location


Repair—Renewal—New Service

Date	Material	Amount	Total	Date	Amount
	<i>New Service</i>				
28'	1" pipe @ .20	5 60			
1	S & W	2 75			
1	1" Brass Nipple	20			
1	1" Ell	15			
	Trucking	75	9 45	9-6-74	
	Total Labor		60		
	15% Overhead		09	15'	3/4 Copper
	Construction Charge		3 00	1	3/4 Corp. Adapter
			13 14	1	3/4 C Curb Cock
				1	1" Repair Clamp
				1	1"x6" CL Nipple
				1	1" Coupling
				4'	Corr. Drain Pipe
				1	Box and Rod
				2	Hrs. Town Shovel
				2	Hrs. Town Trucking
					Patch 14'x5'

DATE _____

TOWN OF LEXINGTON — BOARD OF PUBLIC WORKS
WATER DIVISION

Sketch of Service Here

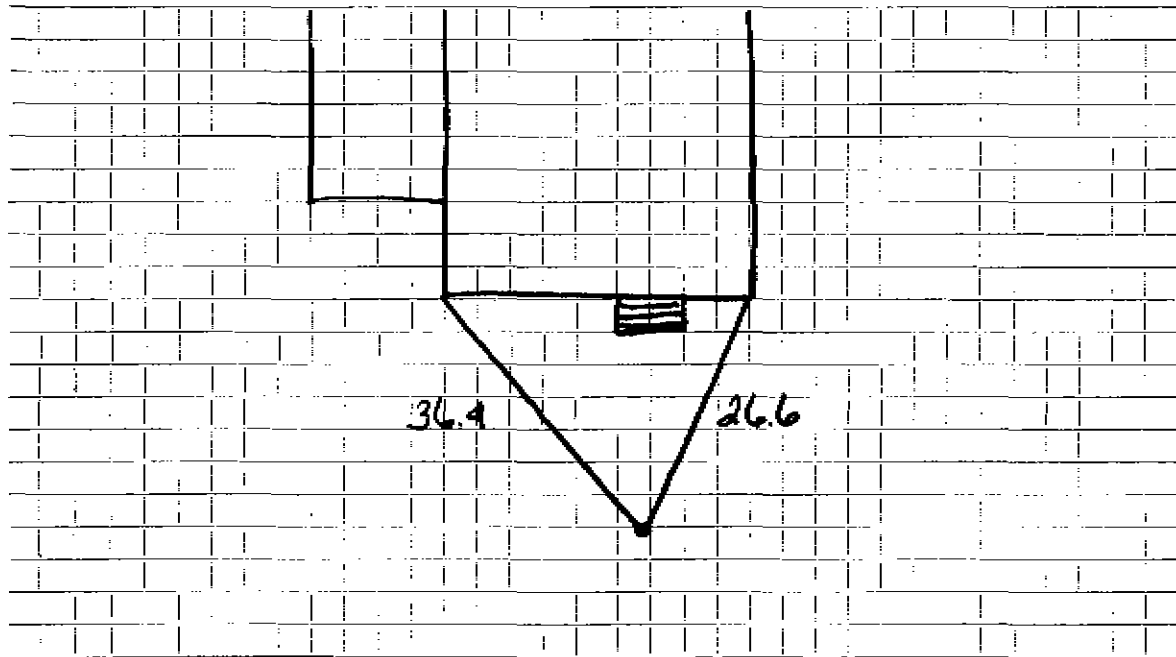

Connection made in Street. Work completed

Remarks:
.....
.....