

Name Dr. Lawrence Pious  
 Address 255 Bedford Street  
 Lexington, Mass.

Service No.

#5338  
 #6643

Location 255 Bedford Street

Kind of Pipe

Size

Size of Main

~~REPAIR~~—Renewal—~~NEW SERVICE~~

Com. 7-5-49

Location

Date	Material	Amount	Total	Date	Amount
Apr. 15, '49	Labor	1 25	1 25		
	10% Overhead		13		
	80' - 3/4" Copper Tubing @.27		21 60		
	1 - 3/4" v x 1/2" I.W.H. P&W		3 29	July 14 '49	
	1 - 3/4" C x 3/4" C Union (3pts)		1 39		
	Trucking 1 hr. @.75		75		
			28 41	4/8/85	
				15'	3/4" Copper tubing
				1	3/4" Corp
				1	3/4" Curb
					Patch 12'x7'x6" Street
					Binder 9'x6'x3" Sidewalk
	Labor				

*No deposit  
 Paid*

Non-Charge

*July 14 '49*

1 - 1/2" Tail Piece

Renewal W.O. #1169

Patch 12'x7'x6" Street

Binder 9'x6'x3" Sidewalk

28 41

37

TOWN OF LEXINGTON - BOARD OF PUBLIC WORKS  
**WATER DIVISION**

The undersigned applies for a supply of water at No..... St. and hereby agrees to comply with the rules and regulations as now, or at any future time, established by the Board of Selectmen.

Am't of Estimate \$.....


Owner .....

Am't Paid \$.....

Address .....

Builder .....

Sketch of Service Here

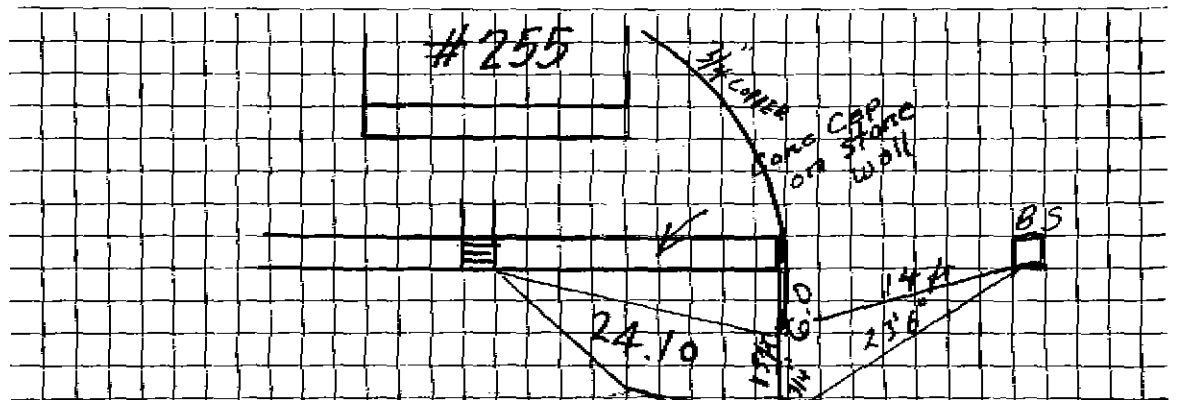

Connection made in ..... Street.

31" Work completed ..... 19

Remarks:

3/4" C&P  
 5' X 0' 0" 0'