

Name Wesley R. Colwell

Service No. ~~33~~ 173

Address 118 Capen St., Medford
~~#257 Bedford Street~~ Location

²⁵⁷
~~#3~~ Bedford St. #3148

Kind of Pipe Size Size of Main

~~Repair - Renewal~~ - New Service Location

Date	Material	Amount	Total	Date	Amount
Apr 22-30	43 1/2" Copper Pipe @ .15	6 45			
12-31-32	1 1/2" " Bend	60			
	1 S & W	2 75			
	Trucking	75	10 55		
1/18/32-7	Hrs. Labor @ .55	3 85			
	3 " " @ .60	1 80	5 65		
	15% Overhead		85		
	<u>COST</u>		17 05		
	Mr. Colwell deposited \$22.20, and				
	43' @ .60 is \$25.80, but say		<u>\$22 20</u>		
	Labor				

Nov. 14 1932 - Cash 22 20

4/22/35 3/4 COPPER OUTSIDE
[Signature]

Hadley Press, Inc., Lexington

37.
22.2

DATE October 19, 1932.

TOWN OF LEXINGTON—BOARD OF PUBLIC WORKS

WATER DIVISION

The undersigned applies for a supply of water at No. ²⁵⁷~~143~~ Bedford St. and hereby agrees to comply with the rules and regulations as now, or at any future time, established by the Board of Selectmen.

Am't. of Estimate \$ 22.²⁰


Owner Wesley R Cornell

Am't. Paid \$ 22.²⁰

Address 118 Capen St
Medford

Builder _____

Sketch of Service Here

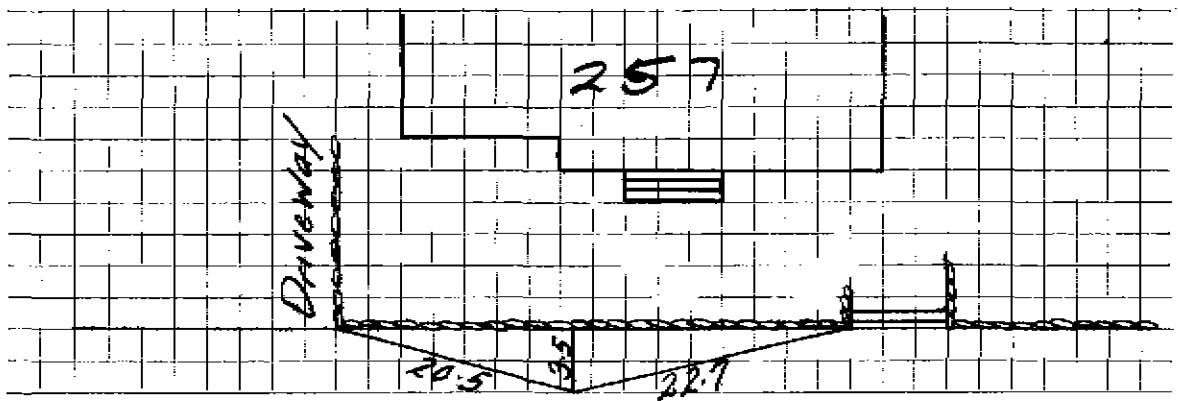

Connection made in _____ Street.

Work completed _____ 19

Remarks: