

Name Colwell Bros.
 Address Bartlett Ave., Lexington
 259 Bedford St.

Service No. 18 175
 # 3997

Location ²⁵⁹ ~~145~~ Bedford St.

Kind of Pipe Size Size of Main

~~Repair-Renewal~~ - New Service

Location

Date	Material	Amount	Total	Date	Amount
7/24/33	55 $\frac{3}{4}$ " C. Pipe @.15	\$8 25		July 5 1933 - Cash	22 -
8-19-33 Com. 33,-	1 $\frac{3}{4}$ "			Aug. 18, 1934 - "	11 -
					33 -
				4/22/35	3/4" COPPER OUTSIDE
					<i>John</i>
	COST	\$33 00			
	Labor				

Hadley Press, Inc., Lexington

DATE July 5, 1933

TOWN OF LEXINGTON—BOARD OF PUBLIC WORKS
WATER DIVISION

The undersigned applies for a supply of water at No. 145 Bedford St. and hereby agrees to comply with the rules and regulations as now, or at any future time, established by the Board of Selectmen.

Am't. of Estimate \$ _____


Owner Colonel Bros

Am't. Paid \$ 27

Address 15 Bartlett Ave Lex

Builder _____

Sketch of Service Here

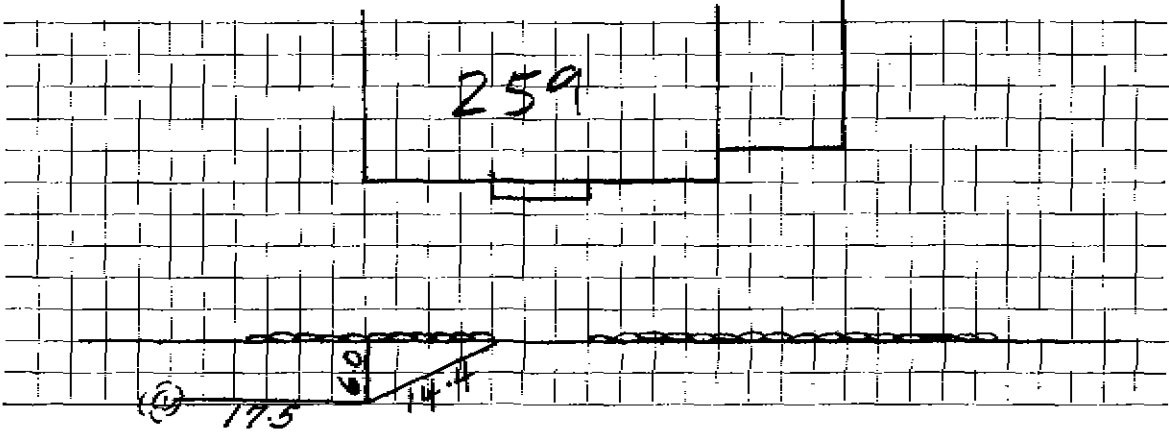

Connection made in _____ Street. Work completed _____ 19

Remarks: