


DATE 10-24-2000

TOWN OF LEXINGTON — BOARD OF PUBLIC WORKS

WATER DIVISION

Sketch of Service Here

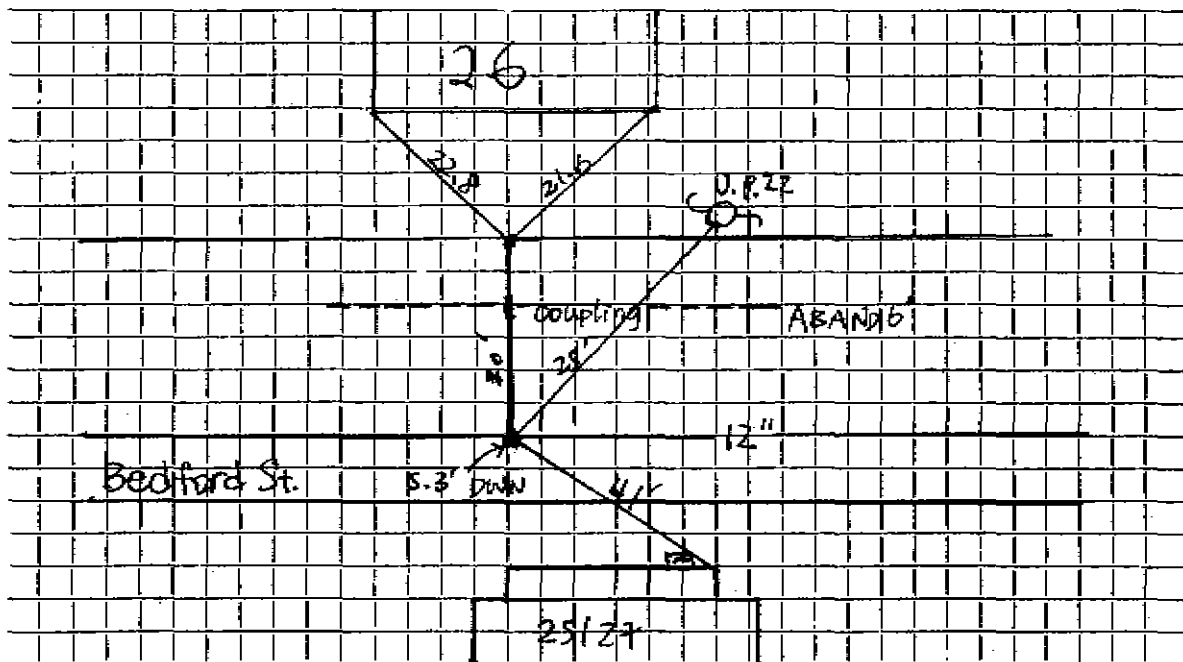

Connection made in Bedford St. Street.

Work completed .. Granese & Sons, Inc. (Defelice Co.)


Remarks: Connection to 12" main w/ 1" copper.

Contract. Coo-12 field book # 1 D of 2000

DATE _____

TOWN OF LEXINGTON — BOARD OF PUBLIC WORKS
WATER DIVISION

Sketch of Service Here

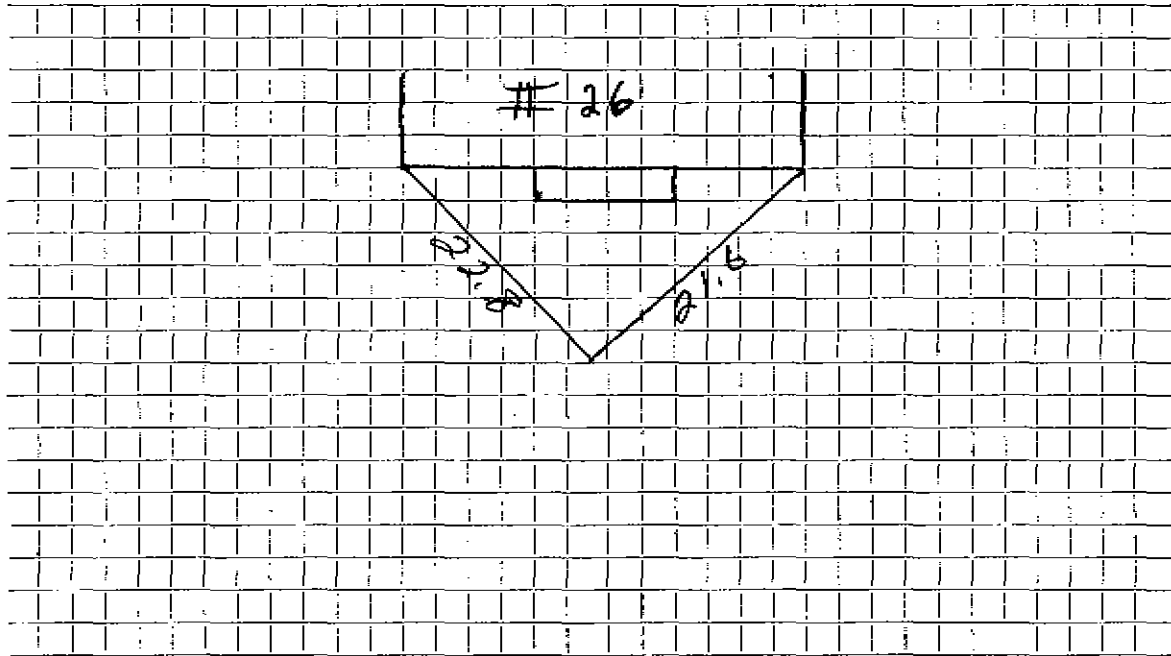

Connection made in Street. Work completed

Remarks:

.....

.....