

Name

John Donnellan

Service No. 177

Address

265 Bedford St. + 9 Hancock

3784

Location

265 Bedford St.

Kind of Pipe

Size

Size of Main

Repair—Renewal—New Service

SEE CARD FOR # 9 N-HANCOCK Location

Date

Material

Amount

Total

Date

Amount

6-10-60	9'	3/4 COPPER			
	1	3/4 COPR ADPT.			
	1	3/4 CURB COCK			
	1	1" LL COUPLING			

Labor

DATE _____

TOWN OF LEXINGTON—BOARD OF PUBLIC WORKS
WATER DIVISION

The undersigned applies for a supply of water at No. _____ St. and hereby agrees to comply with the rules and regulations as now, or at any future time, established by the Board of Selectmen.

Am't. of Estimate \$ _____

Owner

a. Parker.

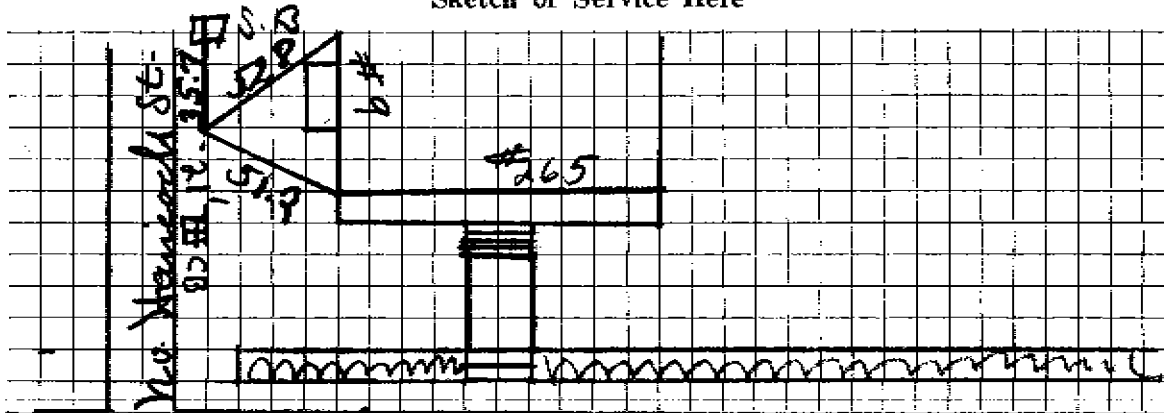
Am't. Paid \$ _____

Address

#53 Bedford St.
265

Builder _____

Sketch of Service Here

Connection made in Bedford Street. St

Work completed _____

19

Remarks: