

#1878

WATER SERVICE RECORD

Name Mrs. June Kelley

Service No. 46

Address 266 Bedford St. Lexington

Location

Repair - ~~Reinstall Meter Service~~ W.O. #5178

MAR 18 1968


Date	Material	Amount	Total	Date	Amount
7/27/67	Labor	67.16		7/27/67	Deposit 200 00
8/7/67	Labor	8.64		4-4-68	Paid 39 05
8/29/67	Labor	51.95	127 75		239 05
	10% O.H.	12 78	140 53		
68'	3/4" copper @.79		53 72		
1	3/4" wheel valve		9 30	2 hrs. shovel @6.50	13 00
4	hr. trucking @3.00		12 00	1/2 hr. compressor @5.00	2 50
3	hr. shovel @6.50		19 50	1 1/2 yd. cement @1.55	2 32
1/2	hr. compressor @5.00		2 50	4 ton hot top @5.80	23 20
1/2	hr. roller @3.00		1 50	1 3/4" union	3 05
			239 05	1 3/4" curb cock	8 76
				1 box & rod	5 10
	<u>OUTSIDE</u>			1 3/4" adaptor	2 76
7/23/67	Labor	67.16		700 lbs. cold patch	5 00
8/7/67	"	8.64		21' copper tubing @.79	16 59
8/29/67	"	51.94	127 74	2 yards loam @3.00	6 00
8	hrs. Policemen @8.50		28 00	2 lbs. grass seed @1.10	2 20
2	hrs. trucking @3.00		6 00		252 22

DATE _____

TOWN OF LEXINGTON — BOARD OF PUBLIC WORKS

WATER DIVISION

Sketch of Service Here

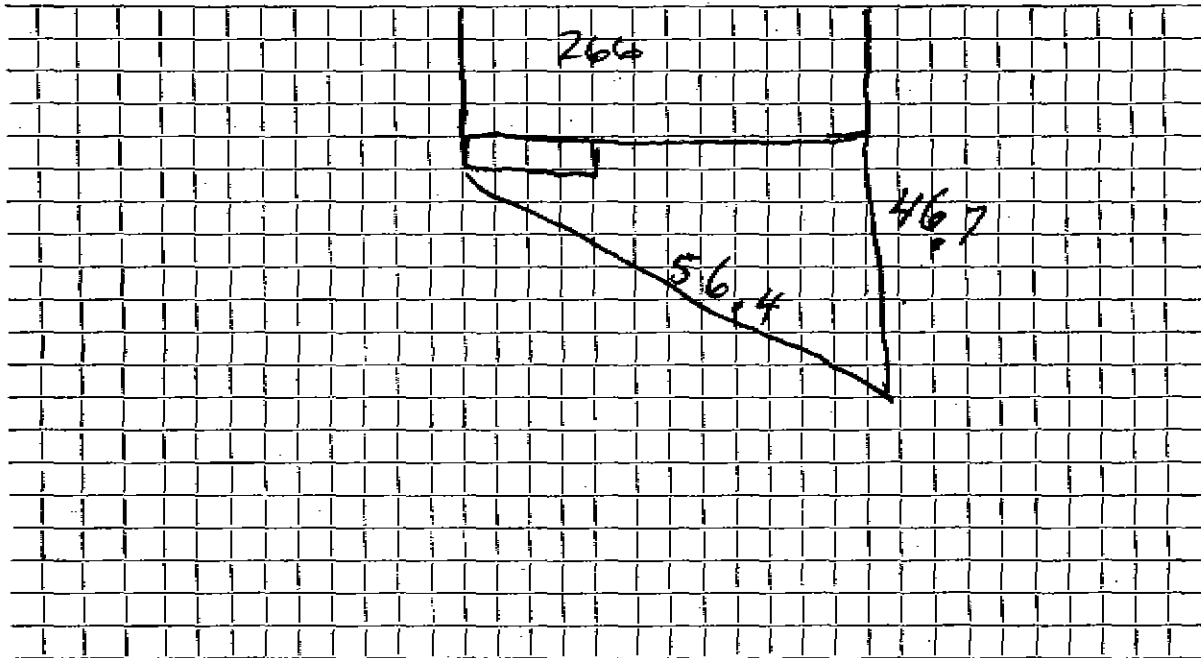

Connection made in Street. Work completed

Remarks:
.....
.....