

**WATER SERVICE RECORD**

Name

Service No.

Address 268 Bedford Street

Location


Repair—~~Renewal~~—~~New Service~~ W.O. 1176

Date	Material	Amount	Total	Date	Material	Amount
					OUTSIDE	
				4/4/85	20' 3/4" Copper tubing	
					1 Med. Corp. Adapter 3/4"	
					1 3/4" Curb	
					1 C.L. Nipple 1" x 4"	
					1 L.L. Coupling	
					1 1" Style 38	
					1 Box & Rod	
					1 Ton Cold Patch	

DATE \_\_\_\_\_

TOWN OF LEXINGTON — BOARD OF PUBLIC WORKS  
WATER DIVISION

Sketch of Service Here

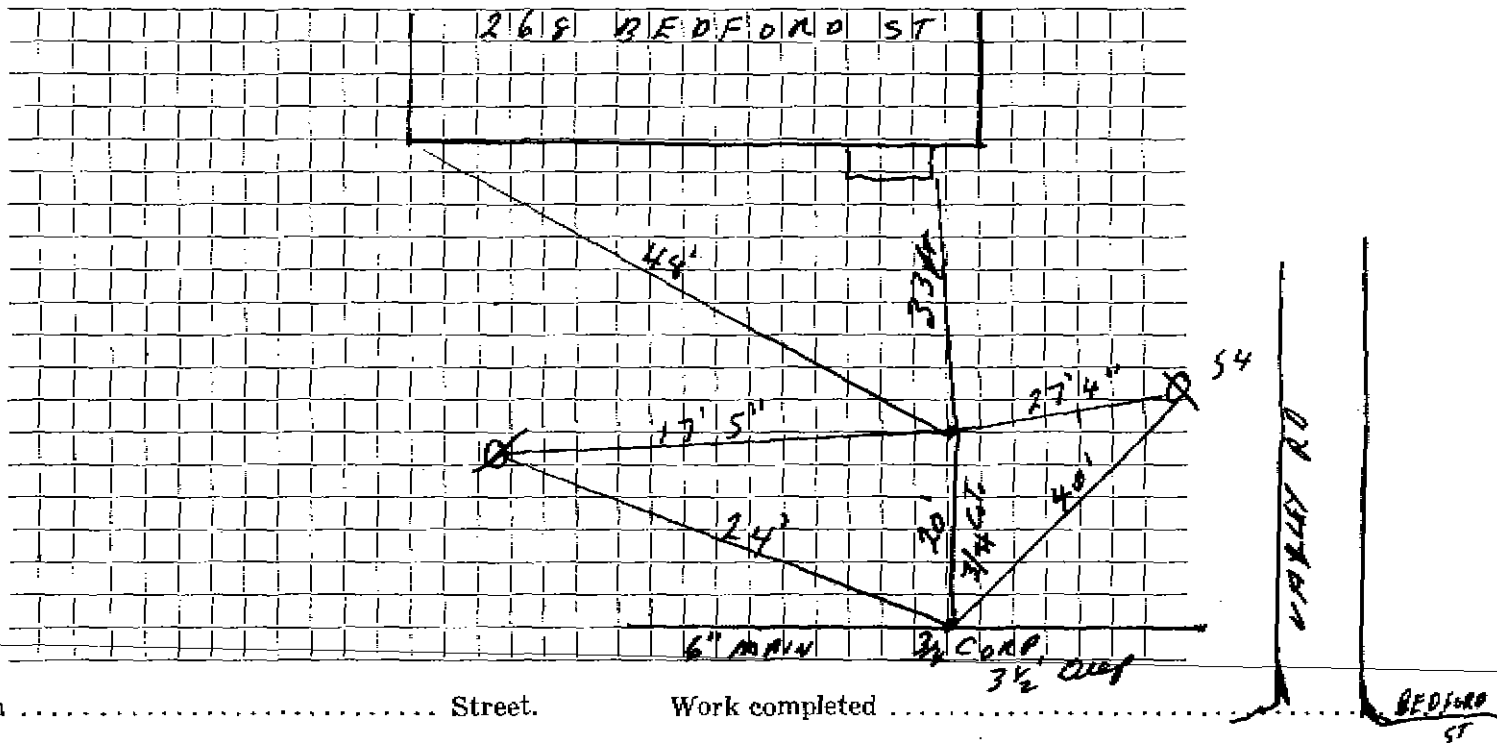

Connection made in ..... Street. Work completed .....

Remarks: .....  
.....  
.....