

# WATER SERVICE RECORD

Name

Service No.

Address

*277 Bedford Street*

Location

Repair—Renewal—New Service


Date	Material	Amount	Total	Date	Material	Amount
<i>7/28/50</i>	<i>Labor</i>	<i>27. 05</i>				
	<i>10% G.H.</i>	<i>2. 71</i>	<i>29.76</i>			
	<i>44' 3/4" Copper Tubing @.23</i>		<i>10.12</i>			
	<i>1 3/4" C x 1/2" I.W.H.S. &amp; W.</i>		<i>3.29</i>		<i>OUTSIDE</i>	
	<i>1 3/4" C x 3/4" C Union 3 parts</i>		<i>1.39</i>	<i>8/1/50</i>	<i>Labor</i>	<i>28. 50</i>
					<i>20' 3/4" Copper tubing</i>	<i>4.60</i>
					<i>1 3/4" C Corp. Cock</i>	<i>3.15</i>
					<i>1 3/4" C x 3/4" C Curb Cock</i>	<i>3.85</i>
					<i>1 Box &amp; Rod</i>	<i>3.35</i>

DATE \_\_\_\_\_

TOWN OF LEXINGTON — BOARD OF PUBLIC WORKS

**WATER DIVISION**

Sketch of Service Here

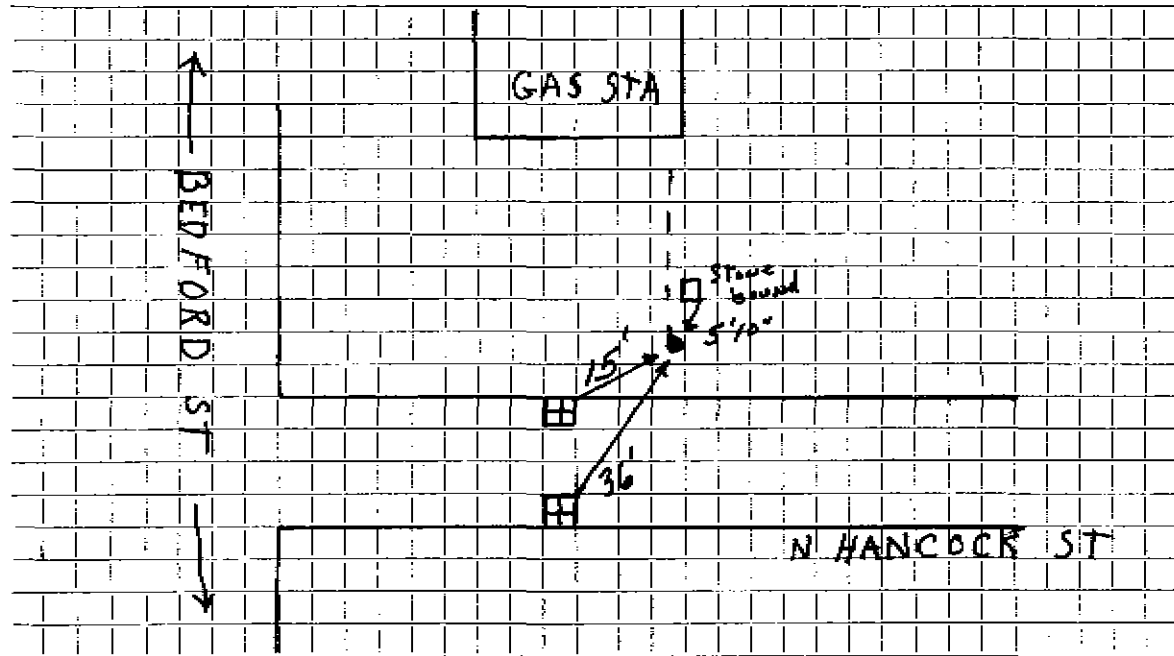

Connection made in ..... Street. Work completed .....

Remarks: .....

.....

.....