

WATER SERVICE RECORD

Name George F. Smith

Service No. 20

Address 282 Bedford St.

Location

~~Renewal~~ ~~Service~~ W.O. # 6408

JUL 7 1969


Date		Material	Amount		Total	Date		Amount	
6/3/69		Labor	101	28		6-3-69	Diposit	341	06
6/4/69		"	37	60		7-22-69	Rebate	17	40
6/10/69		"	10	46				240	00
6/11/69		"	16	34	165				
		10% O.H.			16	13	3/4 COPPER		
		40' 3/4" Copperpipe .79			31	3/4	CORP		
		1-3/4 X 2 W.H.S. & W.			9	3/4	CURB		
		1-3/4 Copper 3 part union			3		Box + Rod		
	2	Yds. Loam 3.50			7				
	2	Lbs. Grass seed 1.10			2				
	3	Hrs. trucking 3.00			9				
	2	" shovel 6.50			13				
					257				
					40				

DATE _____

TOWN OF LEXINGTON — BOARD OF PUBLIC WORKS

WATER DIVISION

Sketch of Service Here

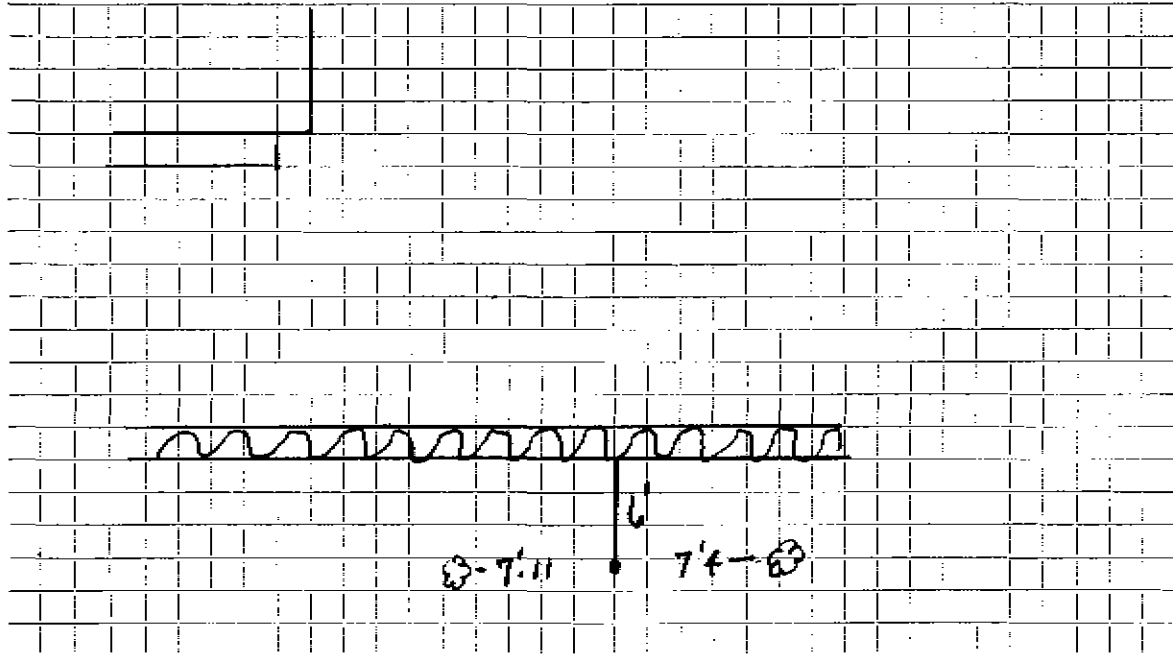

Connection made in Street. Work completed

Remarks:

.....

.....