

Name Norman T. May

Address 285 Bedford Street

Lexington, Mass.

Service No.

4290
4317

Location 285 Bedford Street

Kind of Pipe

Size

Size of Main

~~Repair~~—Renewal—~~New Service~~

Location

Date	Material	Amount	Total	Date		Amount
					No Charge	
				25'	- 3/4" Copper Tubing @.24	6 00
				1	- 3/4" C Corp-cock	3 15
				1	- 3/4"C x 3/4"C Curb-cock	3 85
				1	- 3/4"C x 3/4"C Union (3pts)	1 39
						<u>14 39</u>
	Labor					

DATE _____

TOWN OF LEXINGTON - BOARD OF PUBLIC WORKS
WATER DIVISION

The undersigned applies for a supply of water at No..... St. and hereby agrees to comply with the rules and regulations as now, or at any future time, established by the Board of Selectmen.

Am't of Estimate \$.....


Owner

Am't Paid \$.....

Address

Builder

Sketch of Service Here

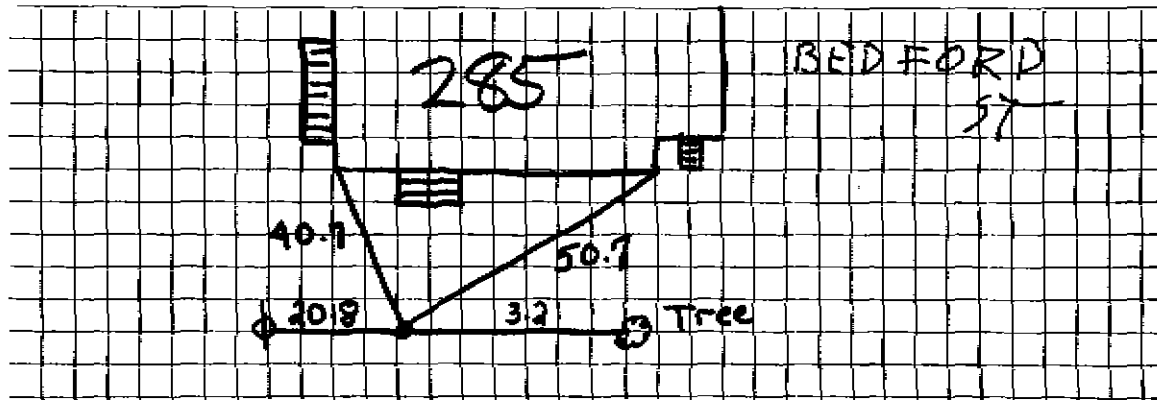

Connection made in Street.

Work completed19

Remarks: