

Name Stanley Phalen

Service No. 103

Address 286 Bedford Street

Lexington, Mass.

Location 286 Bedford Street

1606

Kind of Pipe

Size

Size of Main

~~Repair - Renewal~~ - New Service

Com. 7-3-50

Location

Date	Material	Amount	Total	Date	Amount
June 14, '50	Labor	1 50	1 50	May 22 '50	50 00
	10% Overhead		15	July 20 '50	17 85
	109' - 3/4" Copper Tubing @.23		25 07		32 15
	1 - 3/4" C x 1/2" I.W.H. S&W		3 29	June 14, '50	1 50
	1 - 3/4" C x 3/4" C Union (3pts)		1 39	10' - 3/4" Copper Tubing @.23	2 30
	Trucking 1 hr. @.75		75	1 - 3/4" C Corp-cock	3 15
			32 15	1 - 3/4" C x 3/4" C Curb-cock	3 85
				1 - Box & Rod	3 35
				1 - 1/2" Straight Tail Piece	38
				1 - 1/2" Offset Tail Piece	38
				Trucking 1 hr. @.75	75
					15 66
	Labor				

Deposited
Refunded
No Charge

TOWN OF LEXINGTON - BOARD OF PUBLIC WORKS

WATER DIVISION

The undersigned applies for a supply of water at No..... St. and hereby agrees to comply with the rules and regulations as now, or at any future time, established by the Board of Selectmen.

Am't of Estimate \$.....

Owner


Am't Paid \$.....

Address

Builder

.....

Sketch of Service Here

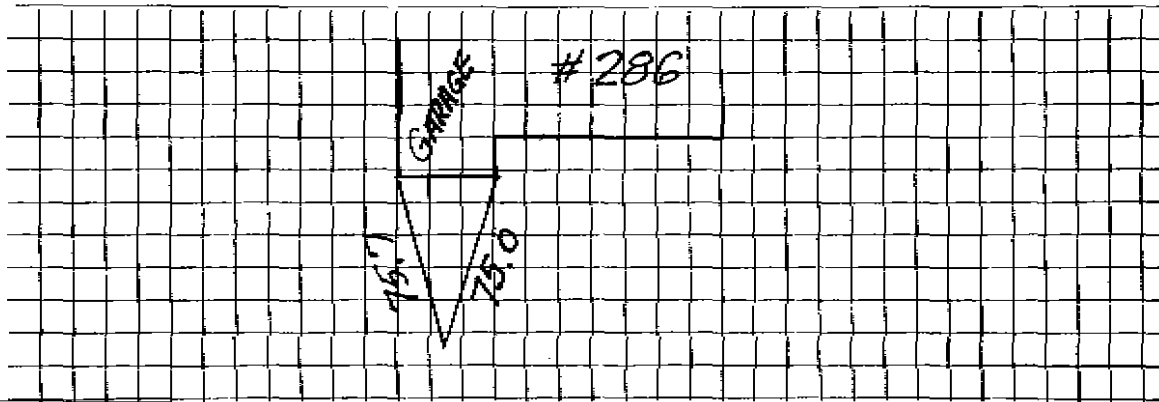

Connection made in Street.

Work completed19

Remarks: