

Name Wm. Maloney

Service No. 37183

Address 77 Baker Avenue  
289 Bedford St.

# 5867

# 7533

Location 289 Bedford Street

Kind of Pipe

Size

Size of Main

~~Repair-Renewal~~—New Service

Location

Date  
1938

Material

Amount

Total

Date

Amount

Aug. 5

2 hrs. @ 60¢

1 20

July 28, 1938 Deposited

29 00

39' 3/4" C.Tubing @ 20¢

7 80

1 3/4" S. & W.

3 75

Trucking- 2 hrs. @ 75¢

1 50

NO CHARGE

14 25

xxx#2x

1 3/4" C Corp cock

3 15

Flat Rate:

39' @ 50¢

19 50

Trench Repairs

9 50

29 00

Labor

Hadley Press, Inc., Lexington

DATE July 13, 1930

# TOWN OF LEXINGTON—BOARD OF PUBLIC WORKS

## WATER DIVISION

The undersigned applies for a supply of water at No. 289 Bedford St. and hereby agrees to comply with the rules and regulations as now, or at any future time, established by the Board of Selectmen.

Am't. of Estimate \$ \_\_\_\_\_

Owner

J. Maloney


Am't. Paid \$ \_\_\_\_\_

Address

77 Baker Ave  
Lexington

Builder \_\_\_\_\_

Sketch of Service Here

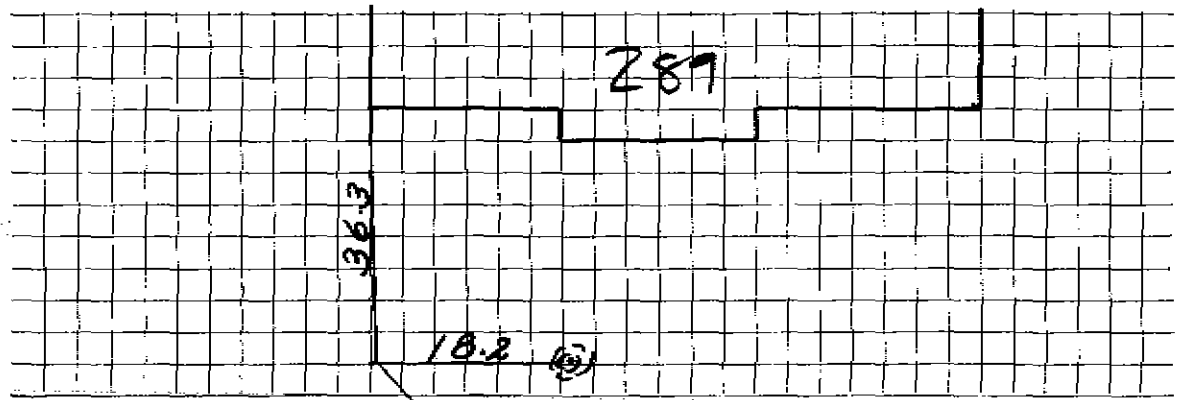

Connection made in \_\_\_\_\_

Street.

Work completed \_\_\_\_\_

19

Remarks:

