

Name Lester Ross
 Address 293 Bedford Street

Service No. ⁷⁵
 #4051 #4515

1226

Location 293 Bedford Street

Kind of Pipe Size Size of Main

~~Repair~~—Renewal—~~New Service~~ Com. 8-15-49 Location

Date	Material	Amount	Total	Date	Amount
June 15, '49	Labor	30 33	30 33	June 6, '49	Deposited Refunded
	10% Overhead		3 04	Aug 25 '49	
	43' - 3/4" Copper Tubing @ .24		10 32		Non-Charge
	1 - 3/4" C x 1/2" I.W.H. S&W		3 29	1 - 3/4" C x 3/4" I Union	88
	Trucking 1 hr.		75	1 - 1/2" Offset Tail Piece	37
			<u>47 73</u>		<u>1 25</u>
				No charge	
				25' 3/4" Copper Tubing @ .24	6 00
				1 3/4" C Corp cock	3 15
				1 3/4" C x 3/4" C Curb cock	3 85
					<u>13 00</u>
	Labor				

DATE _____

TOWN OF LEXINGTON - BOARD OF PUBLIC WORKS

WATER DIVISION

The undersigned applies for a supply of water at No..... St. and hereby agrees to comply with the rules and regulations as now, or at any future time, established by the Board of Selectmen.

Am't of Estimate \$.....

Owner


Am't Paid \$.....

Address *293 Bedford St.*.....

Builder

.....

Sketch of Service Here

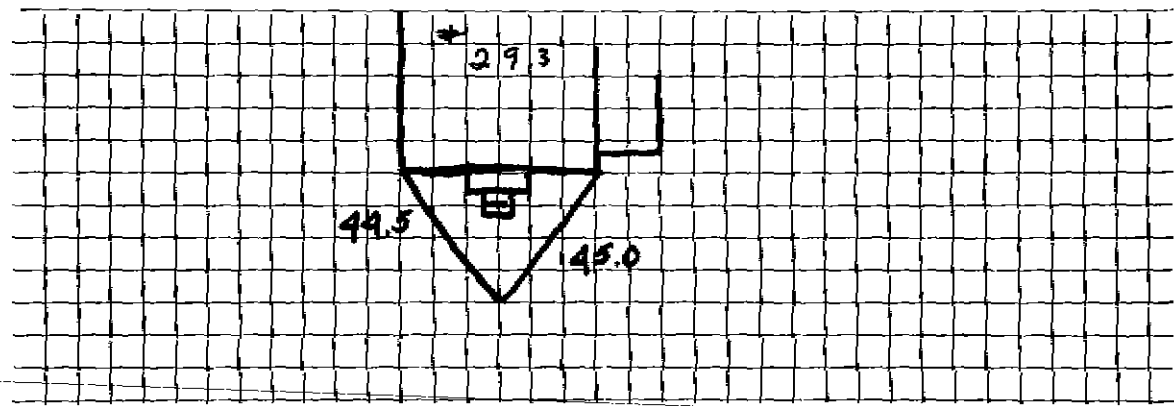

Connection made in Street.

Work completed19

Remarks: