

1947

102

Name Arthur Bernier
Address 296 Bedford Street
Lexington, Mass.

Service No. ~~8423~~
4213

Location 296 Bedford Street

Kind of Pipe Size Size of Main
~~Repair~~ New Service *Com 12/13/47* Location

Date	Material	Amount	Total	Date	Amount
12/20/47	Labor	64 08	64 08	12/20/47	200 00
	10% Overhead		6 41	<i>Deposited</i>	
	273' 1" Copper Tubing @ .38		103 74	<i>April 26 48</i>	26 65
	1 1" Cx3/4 I.W.H. S&W		3 15		226 55
	1 1" Copper Tee		84	12/22/47	25 57
	4 1" Cx1"C. Union (3 pts) @ 1.77		7 08	12/23/47	29 34
	4 hrs. Hired Shovel @ 7.00		28 00	11' 1" Copper Tubing	
	1 hr. Loader		3 00	1 1" C. Curb.Cock	
	1 hr. Compressor		2 75	1 1" Cx1"C. Curb-cock	
	2 hrs. Trucking @ .75		1 50	1 Box and Rod	
	Patching 6x3		6 00	7 hrs. Compressor	
			226 55	2 lbs. Dynamite	
	Labor			4 Caps	
				2 hrs. Trucking @ .75	1 50

Red Seal Date

TOWN OF LEXINGTON - BOARD OF PUBLIC WORKS

WATER DIVISION

The undersigned applies for a supply of water at No..... St. and hereby agrees to comply with the rules and regulations as now, or at any future time, established by the Board of Selectmen.

Am't of Estimate \$.....

Owner


Am't Paid \$.....

Address

Builder

296 Bedford

Sketch of Service Here

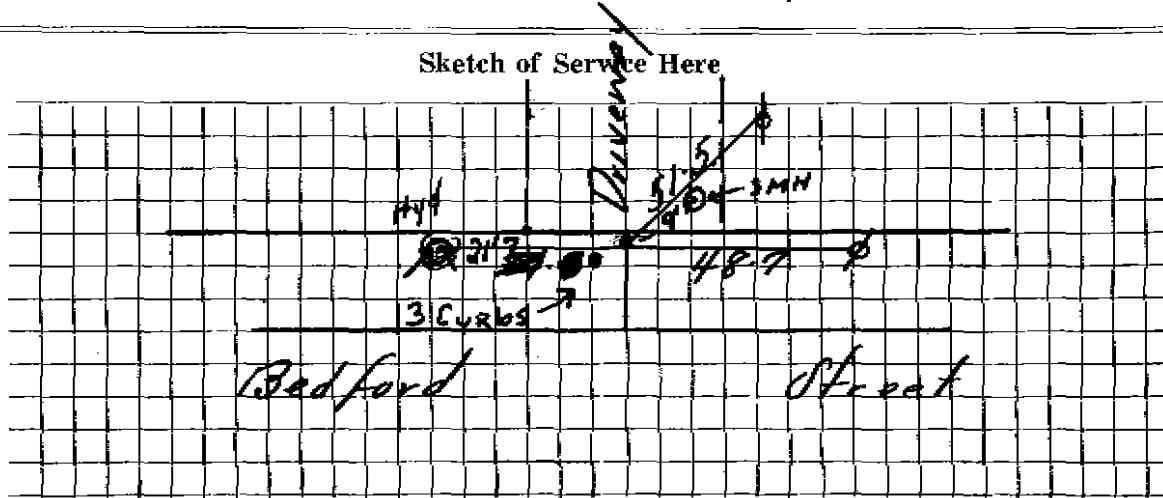

Connection made in Bedford St 3 Curb Boxes Street.

Work completed19

Remarks: