




DATE 1/5/94

TOWN OF LEXINGTON — BOARD OF PUBLIC WORKS  
**WATER DIVISION**

Sketch of Service Here

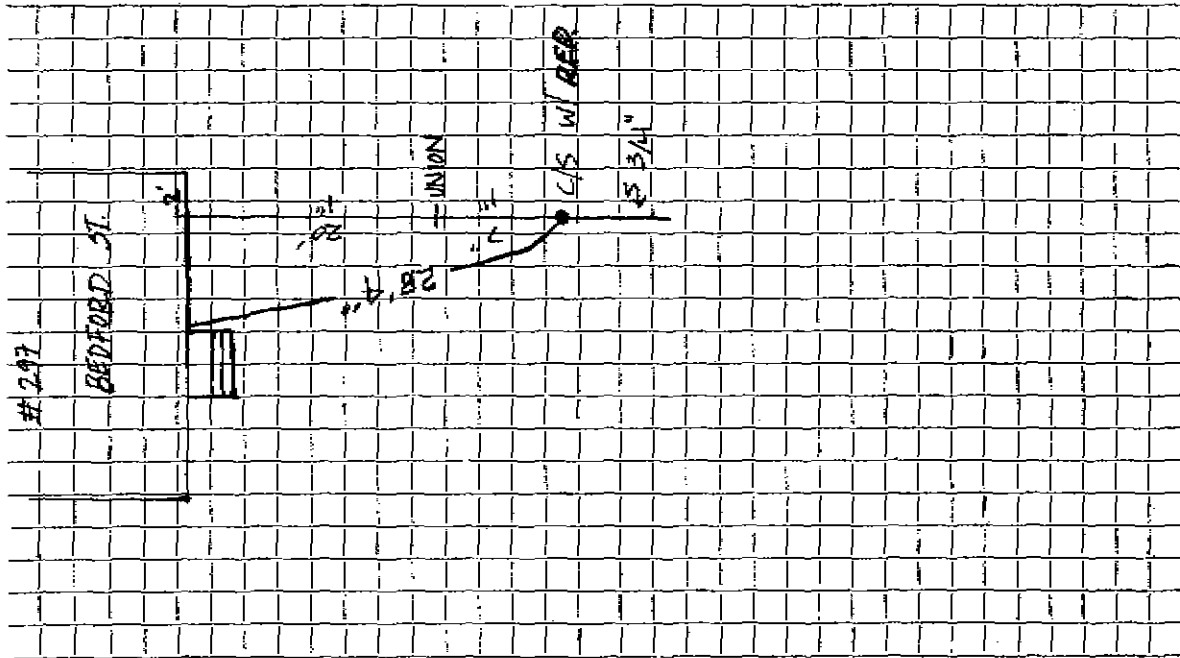

Connection made in ..... Street. Work completed 7/13/93 ARLEX... Co.

Remarks: .....  
.....  
.....