

WATER SERVICE RECORD

Name Thomas F Burke

Service No. 76

Address 298 Bedford Street

Location

~~Repair-Renewal-NEW SERVICE~~ W.O. #3300

OCT 9 1967


Date	Material	Amount	Total	Date	Amount
	<u>RENEWAL</u>				
10/14/66	Labor 83.60			9-19-66	Deposit 1000 00
10/17/66	Labor 79.10			10-9-67	Refund 183 26
10/19/66	Labor 82.00	244 70			816 74
	10% O.H.	24.47			<u>NON-CHARGE</u>
	388' 1" copper tubing @.99		269 17	10/13/66	Labor 41.40
	5 1" Unions @2.81		384 12	10/21/66	Labor 7.98
	2 Bags Rock Wool @1.55		14 05	10/20/66	Labor 85.28
	11 Lbs Grass Seed @ 1.10		3 10	13'	1" copper tub.@ .99
	9 Hrs. Trucking @ 3.00		12 10	1	1" Corp Cock
	15 Hrs. Shovel @ 6.50		27 00	1	1" Curb Cock
	1 1" x 3/4" W.H.Stop & Waste		97 50	1	Box & Rod
			9 70	1/2	Ton Cold Patch @ 5.00
			816 74	3	Ton Hot Top @ 5.50
				7	Hrs. Trucking @ 3.00
				6 1/2	Hrs. Shovel @ 6.50
				1/2	Hr. Compressor @5.00
					257 94

DATE \_\_\_\_\_

# TOWN OF LEXINGTON — BOARD OF PUBLIC WORKS

## WATER DIVISION

Sketch of Service Here

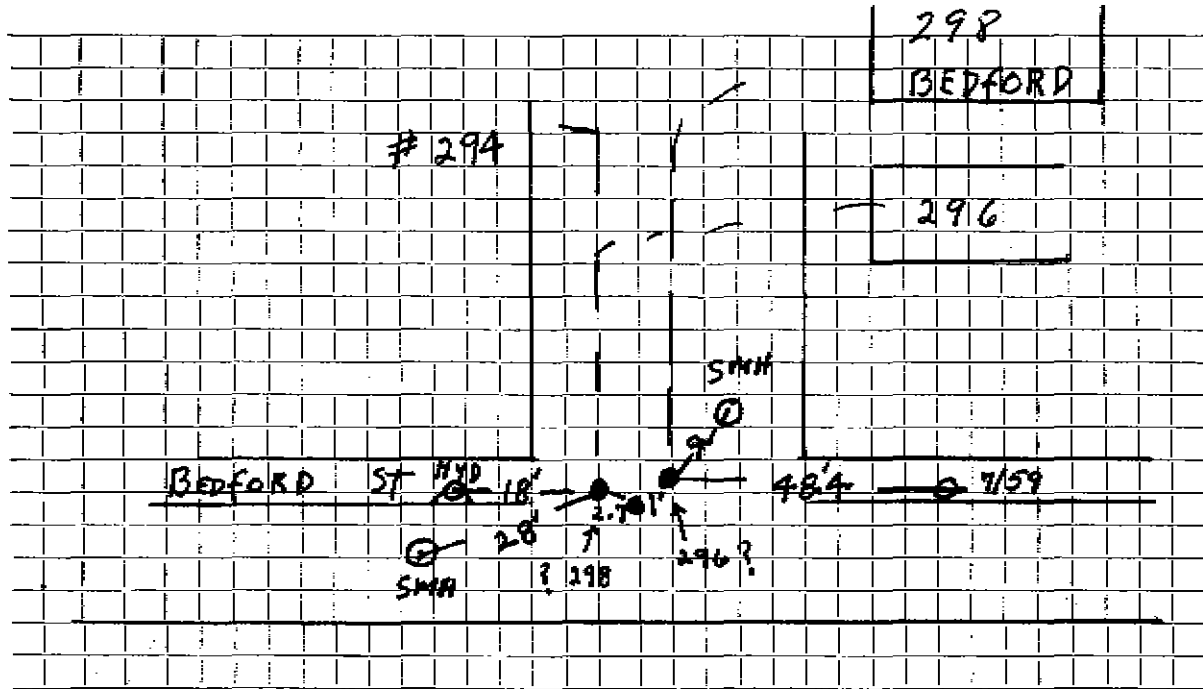

Connection made in Bedford St Street. Work completed .....

Remarks: 3 Curb Boxes