


DATE _____

TOWN OF LEXINGTON — BOARD OF PUBLIC WORKS
WATER DIVISION

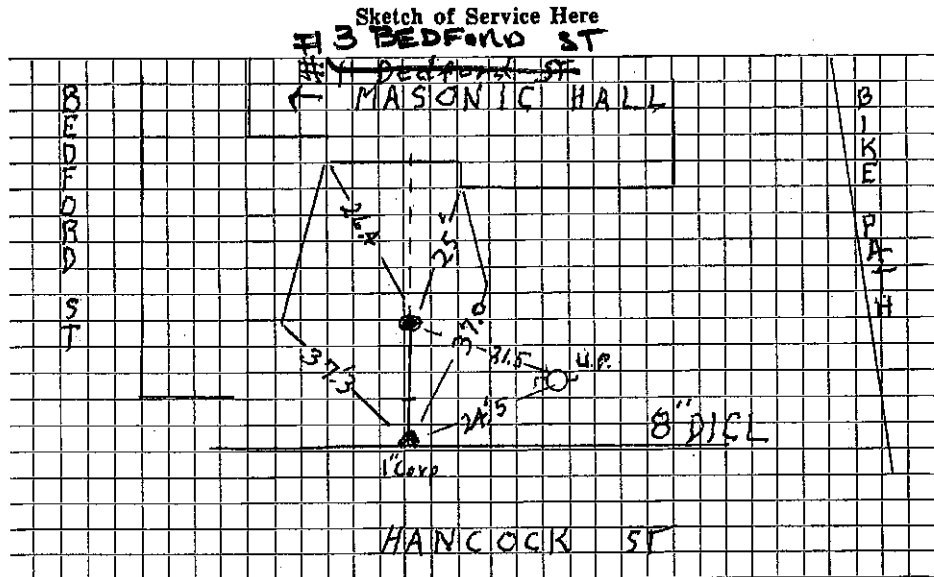

Connection made in hancock Street. Work completed 7/25/12 De. De. De. De.

Remarks:

.....

.....