

WATER SERVICE RECORD

4127

Name Frank W. Tagerty

Service No. 830

Address 301 Bedford Street

Location

Report Renewal New Service

Com. 11-9-53


Date	Material	Amount	Total	Date		Amount
9/30/53	Labor	1.75		10-21-53	Dedged to 0	00 00
	10% Overhead	18	1.93	11-9-53	Refunded	3.80
					NON CHARGE	21.30
	40' - 3/4" Copper tubing @ .3629	14.52	9/30/53	Labor		10.75
	1 - 3/4" C x 1/2 I.W.H. stop & waste	4.00	10/1/53	Labor		25.00
	1 hr. trucking	75	20' - 3/4" Copper tubing @ .3629			7.25
		21.20				
			1 - 3/4" C. curb-cock			4.33
			1 - 3/4" C x 3/4" C. curb-cock			4.67
			1 box and rod			3.90
			1 - 1/2 straight tail piece			50
			1 - 1/2 offset tail piece			50
			4 hrs. Littlefield shovel @ 7.50			30.00
			1 hr. trucking			75
			patching \$ x3			6.00
						93.65

Remarks:

Connection made in

Street

Work completed

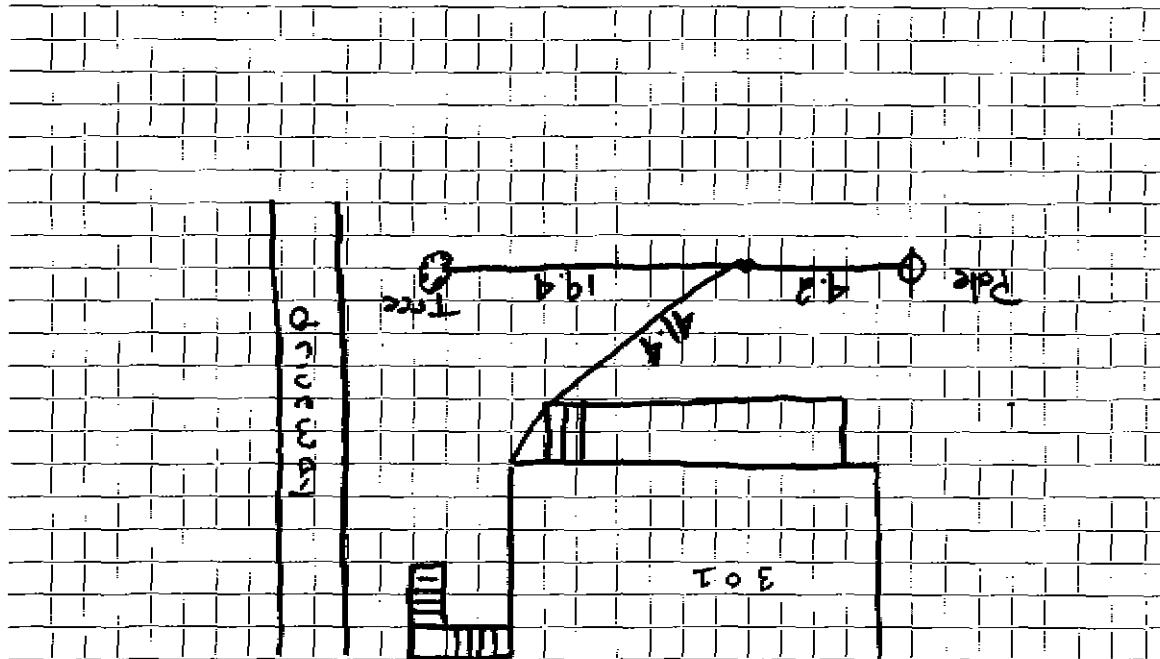

Sketch of Service Here

WATER DIVISION

TOWN OF LEXINGTON — BOARD OF PUBLIC WORKS

DATE