

WATER SERVICE RECORD

Name N.Y. Brother's Trust

Service No. 16

Address 303 Bedford St.

Location

Repair—Renewal—New Service DeFlice Bros. #2495

AUG 16 1976

Date	Material	Amount	Total	Date	Amount
				6/26/74	Deposit 34.18
					NON CHARGE
				6-9-59	Labor 7.90
				26'	3/4" Copper tubing @ .3764 9.79
				1	3/4" C Curb Cock 6.07
				1	3/4" C Corp Cock 4.67
				1	Box & Rod 5.00
				1	hr. Trucking @ .75 75
					<u>34.18</u>


DATE \_\_\_\_\_

TOWN OF LEXINGTON — BOARD OF PUBLIC WORKS

WATER DIVISION

303 BEDFORD ST

Sketch of Service Here

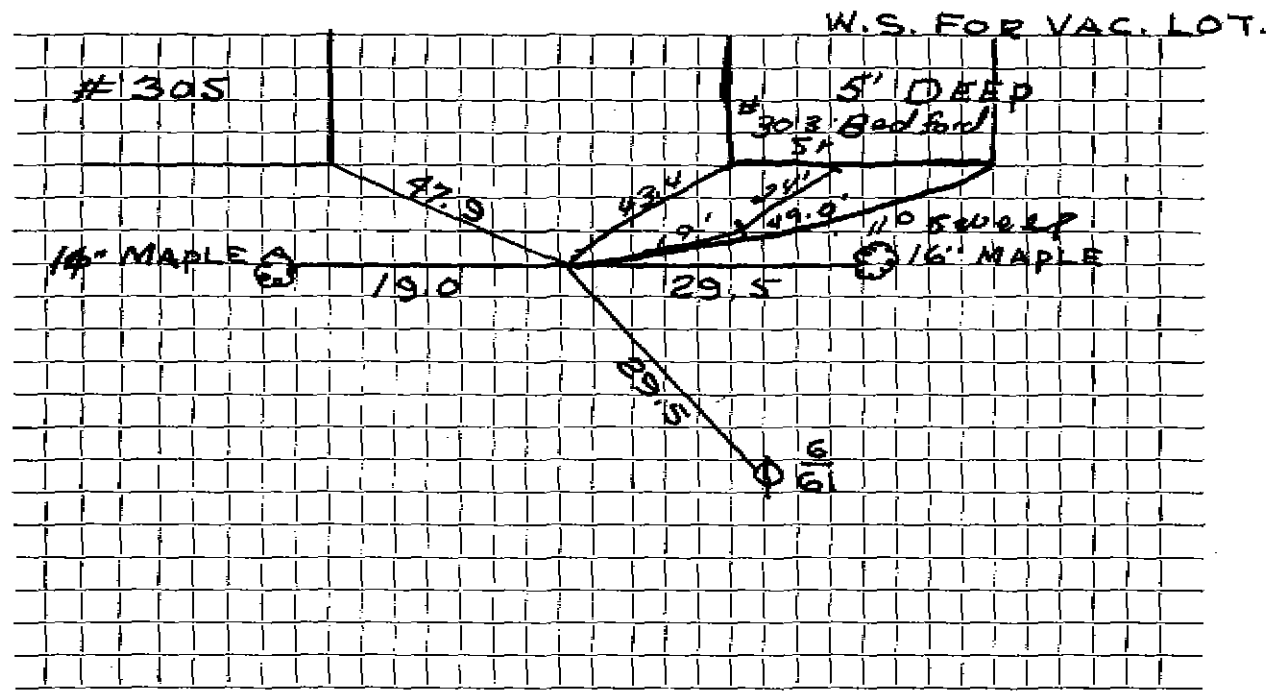

Connection made in \_\_\_\_\_ Street. Work completed \_\_\_\_\_

Remarks: \_\_\_\_\_  
\_\_\_\_\_  
\_\_\_\_\_