

Name Daniel H. Freeman

Service No.

Address 305 Bedford Street

Lexington, Mass.

Location 305 Bedford Street

Kind of Pipe

Size

Size of Main

~~Repair~~—Renewal—~~New Service~~

Location

Date

Material

Amount

Total

Date

Amount

No Charge

25'	- 3/4" Copper Tubing @.24	6	00
1	- 3/4" C Corp-cock	3	15
1	- 3/4" C x 3/4" C Union (3 pts)	1	39
1	- Box & Rod	3	75
		<u>14</u>	<u>29</u>

Labor

TOWN OF LEXINGTON - BOARD OF PUBLIC WORKS
WATER DIVISION

The undersigned applies for a supply of water at No. St. and hereby agrees to comply with the rules and regulations as now, or at any future time, established by the Board of Selectmen.

Am't of Estimate \$.....


Owner

Am't Paid \$.....

Address

Builder

Sketch of Service Here

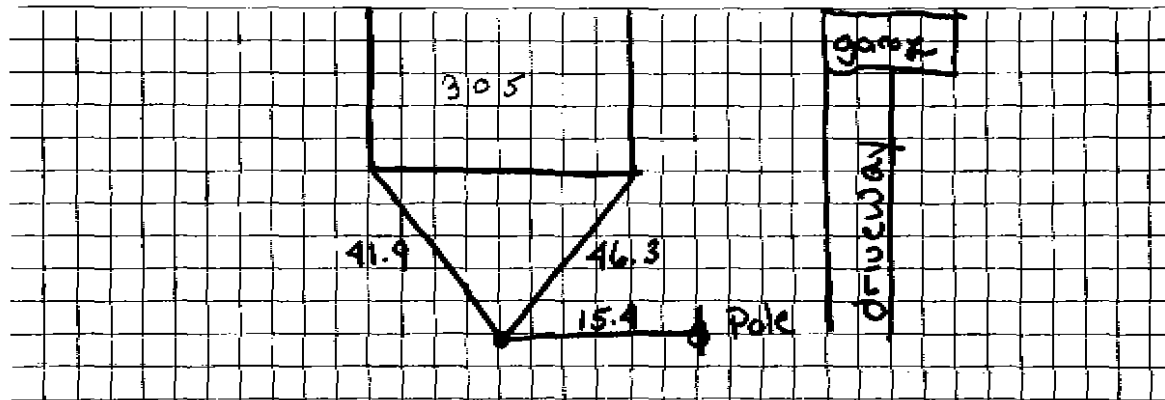

Connection made in Street.

Work completed19

Remarks: