


DATE 28 August 1996

TOWN OF LEXINGTON — BOARD OF PUBLIC WORKS

WATER DIVISION

Sketch of Service Here

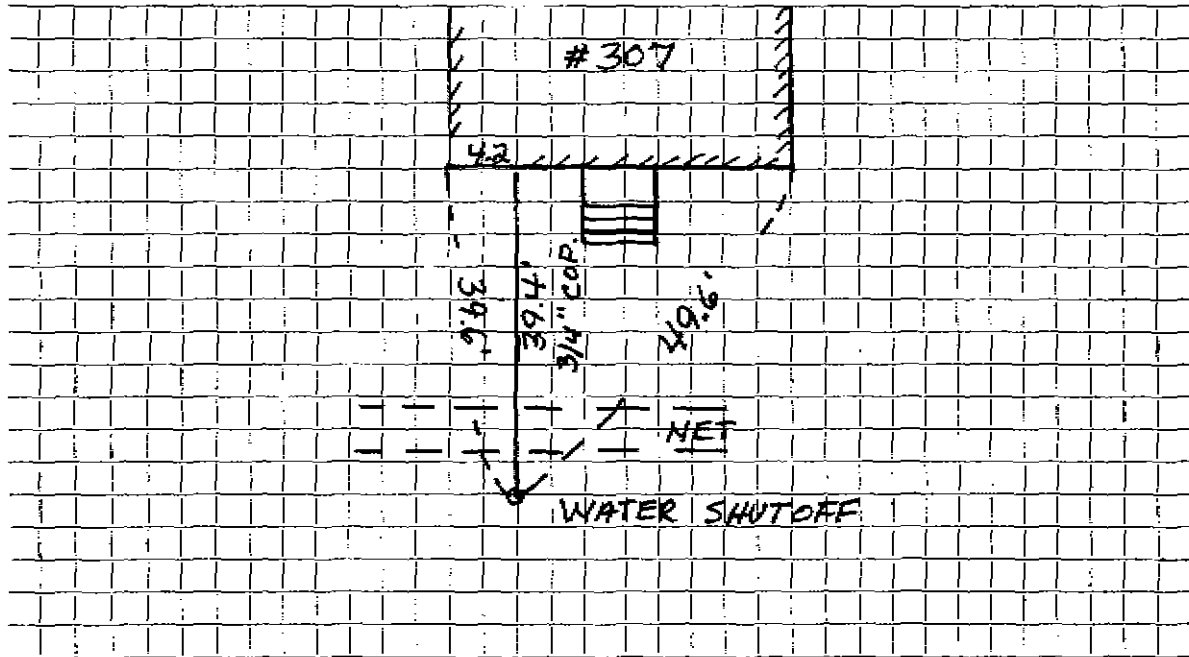

Connection made in ... BEDFORD STREET Street.

Work completed .. BRUCE MCKEE

Remarks: Original service Nov. 19, 1978