

Name

Service No. 195

Address

Location 315 Bedford St.

Kind of Pipe

Size

Size of Main

Repair—Renewal—New Service

Location

Date	Material	Amount	Total	Date	Location	Amount
					NON CHARGE	
	Labor			3/28/62	Labor	45 20
					12' 3/4" Copper tubing @ .42	5 04
					1 3/4" C Curb Cock	6 28
					1 3/4" Adapter	1 62
					12 x 4 patch	12 00
					2 hrs. Town Shovel @ 6.50	13 00
					2 hrs. Trucking @ 3.00	6 00
						89 74
				3-28-62	W.S.T. 75.20	

Hadley Press, Inc., Lexington

DATE \_\_\_\_\_

# TOWN OF LEXINGTON—BOARD OF PUBLIC WORKS WATER DIVISION

The undersigned applies for a supply of water at No. \_\_\_\_\_ St. and hereby agrees to comply with the rules and regulations as now, or at any future time, established by the Board of Selectmen.

Am't. of Estimate \$ \_\_\_\_\_


Owner D. Ayers

Am't. Paid \$ \_\_\_\_\_

Address ~~197~~ Bedford St.  
315

Builder \_\_\_\_\_

Sketch of Service Here

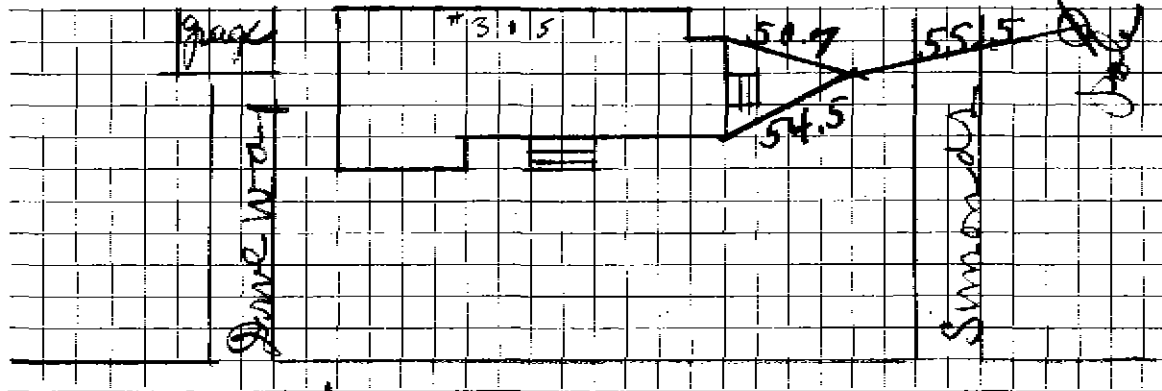

Connection made in Bedford Street. St

Work completed \_\_\_\_\_ 19

Remarks: