

Name Alice Shannon

Service No.

2928

Address 321 Bedford Street

Lexington, Mass.

Location 321 Bedford Street

Kind of Pipe

Size

Size of Main

~~Repair - Renewal - New Service~~

Location

Date	Material	Amount	Total	Date	Amount
	Repair and Renew	W.O. #6365			
3/21/68	Labor	\$99.68			No Charge
3/26/68	"	\$153.33		4' - 3/4" Copper Tubing @.24	96
4/18/68	"	\$18.80		1 - 3/4" C Corp-cock	3 15
4/18/68	"	\$42.39		1 - 3/4" Repair Clamp	<u>1 34</u>
		\$314 20			5 45
	10% O.H.	\$31 42	\$345 62		
3/21/68	1 3/4" Curb Cock	\$11 32		4/18/68	2 Ton Hot Top \$11 60
	1 1" Repair Clamp	\$5 05			5 hrs. Trucking \$15 00
	1 4" Nipple	51			5 hrs. Compressor \$25 00
	1 1" Coupling	60			3 hrs. Shovel \$19 50
	2 hrs. Trucking	\$6 00			1/2 hr. roller and T. \$3 50
	2 hrs. Tractor	\$13 00			
3/26/68	1 Labor-3/4" Corp.	\$7 42		INSIDE	498 52
	27' 3/4" Copper Pipe	\$21 33		4-2-01 4' 1" COPPER	
	1 3/4" Curb Cock	\$11 32		2 3/4" 1" comp. iron report	
	1/2 Ton cold patch	\$2 75			

INSTALLED BY ROCKWELL

DATE \_\_\_\_\_

# TOWN OF LEXINGTON - BOARD OF PUBLIC WORKS

## WATER DIVISION

The undersigned applies for a supply of water at No..... St. and hereby agrees to comply with the rules and regulations as now, or at any future time, established by the Board of Selectmen.

Am't of Estimate \$.....

Owner .....


Am't Paid \$.....

Address .....

Builder .....

.....

Sketch of Service Here

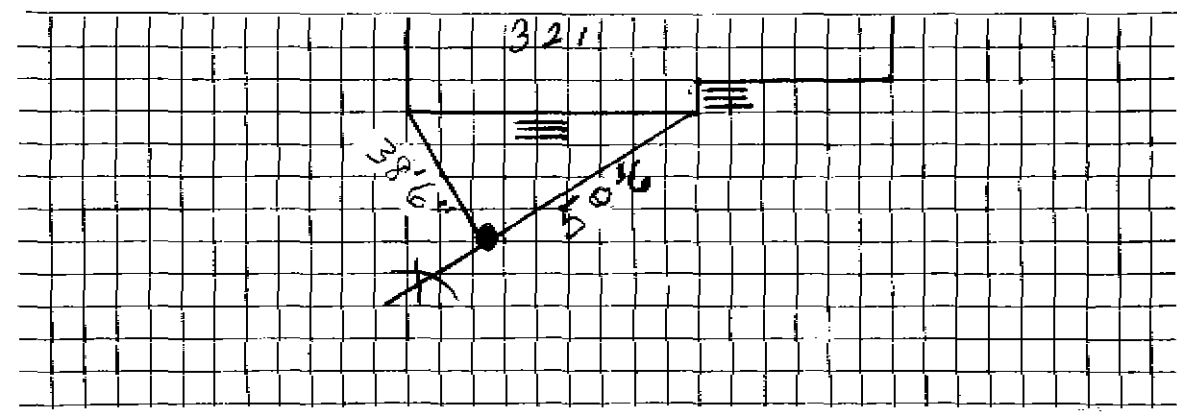

Connection made in ..... Street.

Work completed .....19

Remarks: