

Name George A. Lincoln
 Address 323 Bedford Street
 Lexington, Mass.

Service No.

Location 323 Bedford Street

Kind of Pipe

Size

Size of Main

~~Repair~~ - Renewal - ~~New~~ Service

Location

Date	Material	Amount	Total	Date	Amount
					No Charge
				4' - 3/4"	Copper Tubing @ .24 96
				1 - 3/4"	Corp-cock 3 15
				1 - 1" x 3/4"	C Union (2pts) 1 01
					<u>5 12</u>
					NON CHARGE
				2/23/56	Labor 57 64
					1 Repair Clamp 2 50
					4 2/3 hrs. Littlefield @ 8.50 39 66
					2 hrs. Compressor @ 2.75 5 50
					<u>105 30</u>
	Labor			6-10-01	Repair Made
					12' - 1" Cop
					1 - 1" Curb
					2 - 1 x 1/2 Cop - Iron Adapt.

TOWN OF LEXINGTON - BOARD OF PUBLIC WORKS
WATER DIVISION


The undersigned applies for a supply of water at No..... St. and hereby agrees to comply with the rules and regulations as now, or at any future time, established by the Board of Selectmen.

Am't of Estimate \$..... Owner

Am't Paid \$..... Address

Builder

Sketch of Service Here

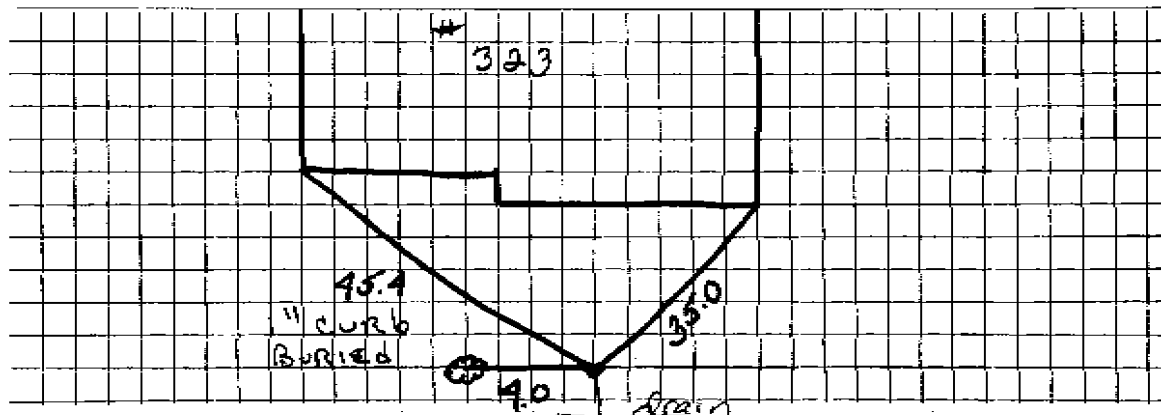

Connection made in Street Gas Work completed19

Remarks: All utilities
 2-2 1/2' APART

