

Name John Bieren

Service No.

Address 324 Bedford Street

Lexington, Mass.

Location 324 Bedford Street

Kind of Pipe

Size

Size of Main

Repair ~~Renewal~~ - New Service

Com. 8-23-48

Location

Date

Material

Amount

Total

Date

Amount

June 16, '48

Labor

1 15

1 15

June 11, '48

Repaired

30 00

10% Overhead

12

Aug. 20, '48

Repaired

6 93

65' - 3/4" Copper Tubing 2.255 16 58

Non-Charge

23 07

1 - 3/4" O x 3/4" I.D.A. 3 15

June 16, '48 Labor

1 15

2 - 3/4" O x 3/4" O Union (3pts) 1 32

10' - 3/4" Copper Tubing .255

2 55

Trucking 1 hr. .75

1 - 3/4" O Core-sock

3 00

23 07

1 - 3/4" O x 3/4" O Core-sock

3 50

1 - Box & Bed

3 55

1 - 1/2" Straight Tail Piece

30

1 - 3" Offset Tail Piece

30

Trucking 1 hr. .75

75

15 28

Labor

Hadley Press, Inc., Lexington

DATE \_\_\_\_\_

# TOWN OF LEXINGTON—BOARD OF PUBLIC WORKS

## WATER DIVISION

The undersigned applies for a supply of water at No. \_\_\_\_\_ St. and hereby agrees to comply with the rules and regulations as now, or at any future time, established by the Board of Selectmen.

Am't. of Estimate \$ \_\_\_\_\_


Owner \_\_\_\_\_

Am't. Paid \$ \_\_\_\_\_

Address \_\_\_\_\_

Builder \_\_\_\_\_

Sketch of Service Here

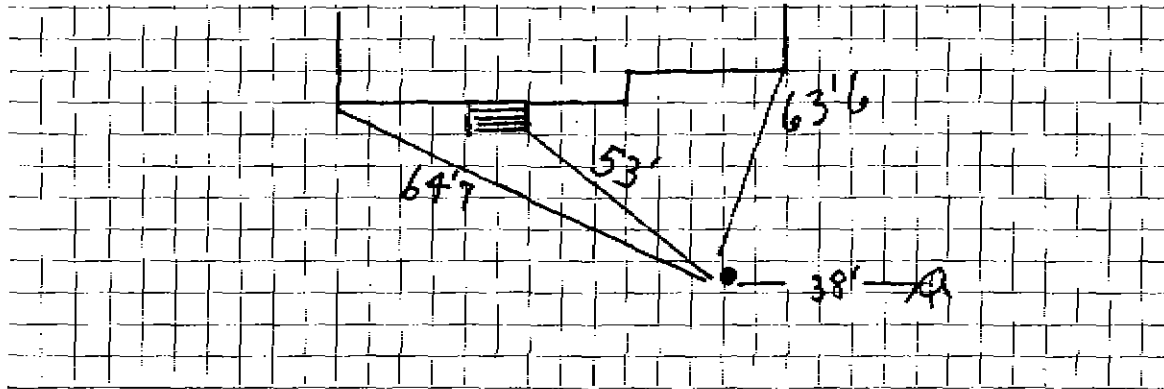

Connection made in \_\_\_\_\_ Street. Work completed \_\_\_\_\_ 19

Remarks: