

WATER SERVICE RECORD

Name Joseph B. Connor

Service No. 1

Address 325 Bedford Street

Location

~~REPAIR~~—Renewal—~~NEW SERVICE~~ W.C. #185


MAY 21 1979

Date	Material	Amount	Total	Date	Amount
1-9-79	Labor	98.60		1-8-79	300.00
	10% O.H.	9.86	108.46		119.56
40'	3/4" Copper tubing @.74		29.60		180.44
1	3/4" Stop & Waste		17.10		
1	3/4" x 1" 2 Part Union		3.72		
1	1/2" x 3/4" Reducer		1.56		
1	90° Tailpiece		1.00		
2	hrs. Trucking @3.00		6.00		
2	hrs. Backhoe @6.50		13.00		
			180.44		

DATE \_\_\_\_\_

TOWN OF LEXINGTON — BOARD OF PUBLIC WORKS  
**WATER DIVISION**

Sketch of Service Here

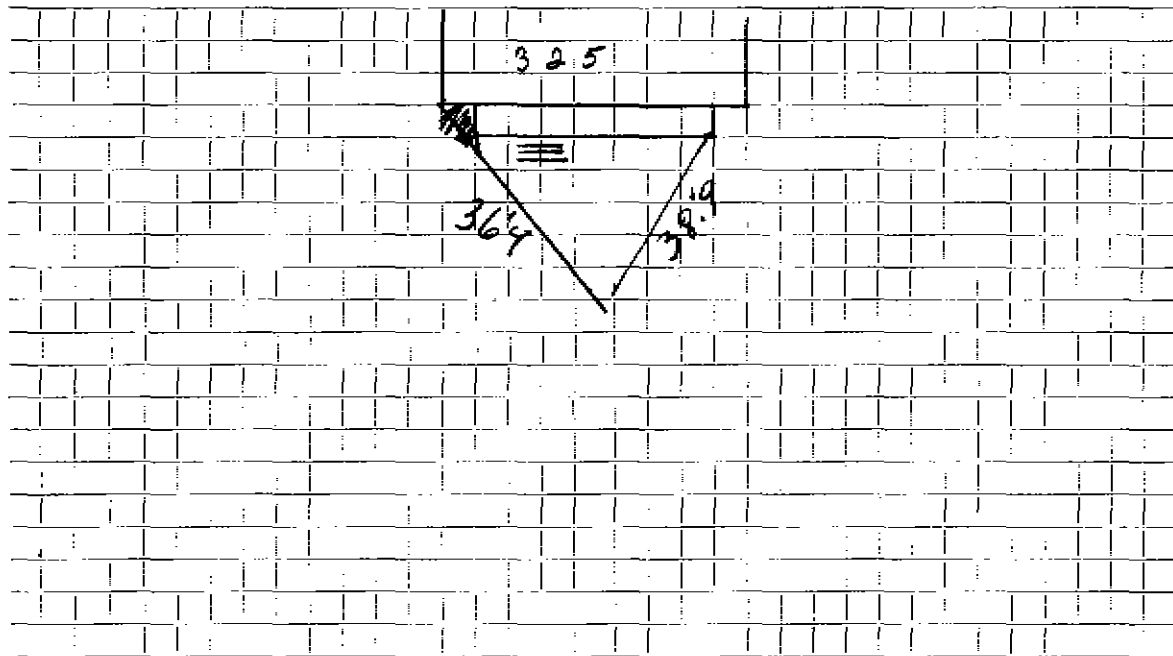

Connection made in ..... Street. Work completed .....

Remarks: .....

.....

.....