

**WATER SERVICE RECORD**

Name **Moore Homes Inc.**

Service No.

Address **33+35 Bedford Street**

Location

Repair—Renewal—New Service **Melone #4083**


Date	Material	Amount	Total	Date	Amount
10/1/82	12" x 6" Tap Sleeve & Gate				
	80' 6" D.I.P.				
	1 6" Plug				
	18' 2" Copper				
	1 6" x 2" Service Saddle				
	1 2" Corporation				
	1 2" Curb Stop				
	1 Roadway Box				
	1 6" x 1½" Service Saddle				
	1 1½" Corporation				
	1 1½" Curb Stop				
	1 Curb Box				
	18' 1½" Copper				

DATE \_\_\_\_\_

TOWN OF LEXINGTON — BOARD OF PUBLIC WORKS

WATER DIVISION

Sketch of Service Here

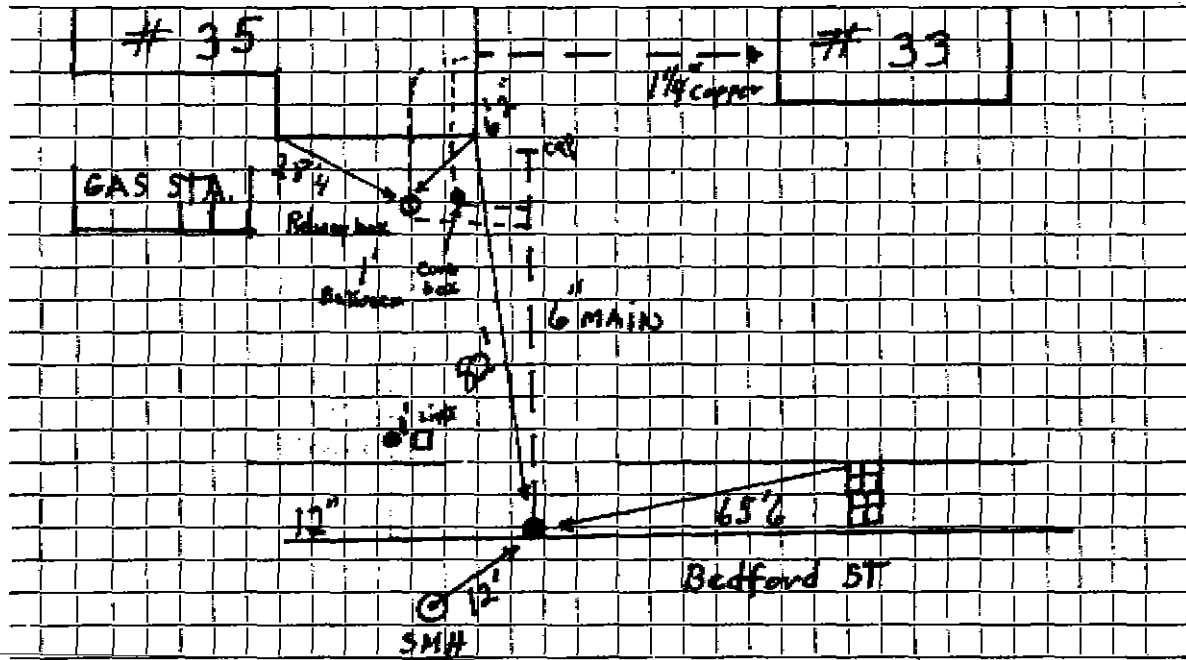

Connection made in Bedford St. Street. Work completed .....

Remarks: 12x6" T.S.G.  
No 35 Feed's No 33 2 meters in 35

## WATER SERVICE RECORD

Name **Rowe Chevrolet**

Service No. **126**

Address <sup>5735</sup>  
~~19547~~ Bedford Street

Location **Changed to #35 Bedford St.\* per Eng. Dept. 12/11/68**

~~XXXXXXXXXXXX~~ New Service DeFlice Bros #122 W.O. #1318

*Mar  
Comm 14, 1966*


Date	Material	Amount	Total	Date		Amount
12-8-65	Labor	32.39		11-22-65	Deposit	50.00
	10% O.H.	3.24	35.63	3-14-66	Paid by SHC #243	54.30
15'	1" Copper tubing @.70		10.50			164.20
1	Curb		8.76			
1	Gorp		7.41			
1	Box & Rod		4.90			
	27 x 3 Patch		27.00			
1	hr. Shovel		6.50			
1/2	hr. Loader @ 4.00		2.00			
1/2	hr. Town Trucking @3.00		1.50			
			104.20			
12-14-65	67' 1" Copper tubing					

DATE \_\_\_\_\_

TOWN OF LEXINGTON — BOARD OF PUBLIC WORKS

WATER DIVISION

Sketch of Service Here

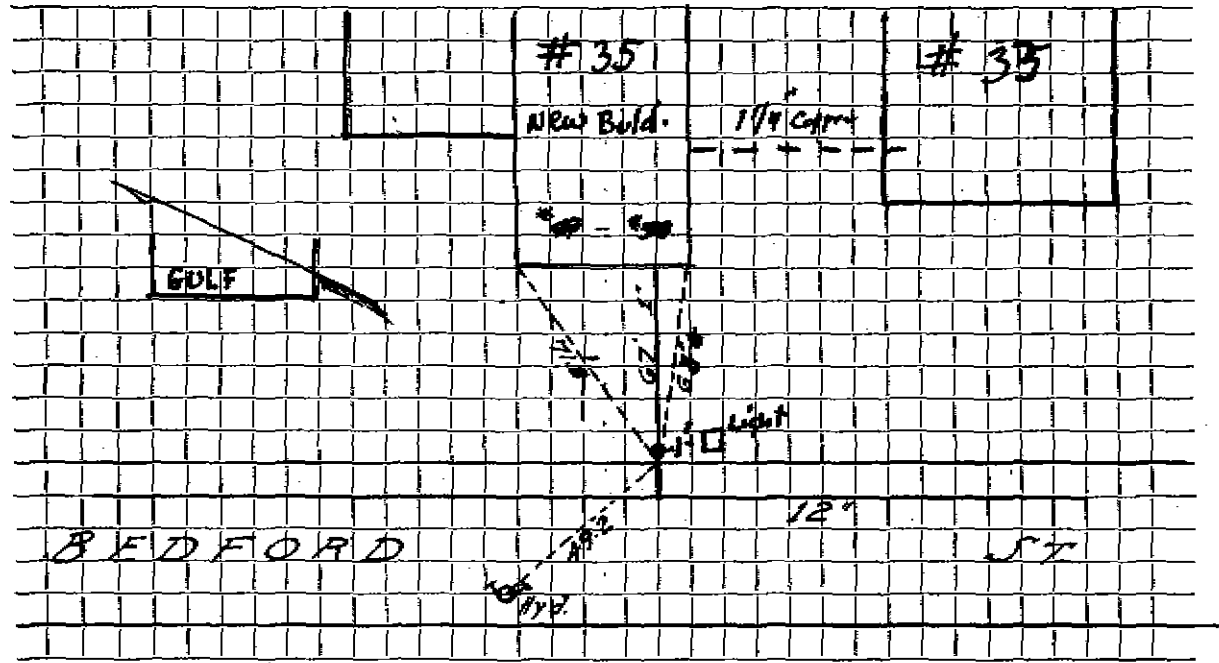

Connection made in ..... Street. Work completed .....

Remarks: .....  
.....  
.....