

WATER SERVICE RECORD

Name

Service No.

Address

Location 330 BEDFORD ST.

Repair—Renewal—New Service


Date	Material	Amount	Total	Date	Material	Amount
11/3/32	68' 3/4 COPPER			10/11/96	CUT IN NEW CURB	
	1 C TO C UNION				1 3/4 MULLER CURB	
	1 C BEND				1 BUFFALO BOX	
	1 S+W					
				DATE ?	1 3/4 CORP	
					1 3/4 UNION	
					1 3/4 REPAIR CLAMP	

DATE \_\_\_\_\_

TOWN OF LEXINGTON — BOARD OF PUBLIC WORKS

**WATER DIVISION**

Sketch of Service Here

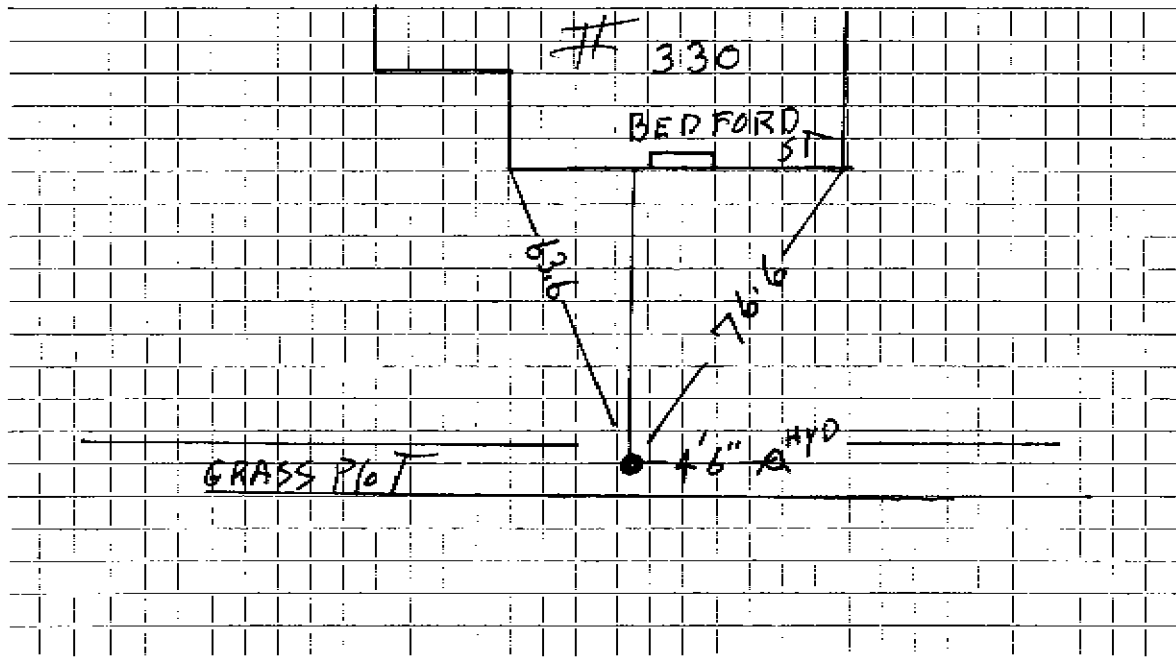

Connection made in ..... Street. Work completed .....

Remarks: .....

.....

.....