

WATER SERVICE RECORD

Name

Service No.

Address

331 Bedford Street

Location

Repair—~~REPAIR~~ NEW SERVICE


Date	Material	Amount	Total	Date	NON CHARGE	Amount
				9/22/56	Labor	21 45
				9/23/56	Labor	75 29
				10/1/56	Labof	24 87
				15'	3/4" Copper tubing @.4396	6 60
				3 Hrs.	Littlefield Shov.@8.50	25 50
				2 Hrs.	#36 @ 2.75	5 50
				1 Hr.	trucking @ .75	75
				2 Hrs.	#45 @ 2.00	4 00
				1 3/4	Corp Cock	4 64
				1 Box	& Rod	4 62
				1 3/4	Curb Cock	5 94
				1 3/4"	Repair Clamp	2 50
						181 66

DATE _____

TOWN OF LEXINGTON — BOARD OF PUBLIC WORKS

WATER DIVISION

Sketch of Service Here

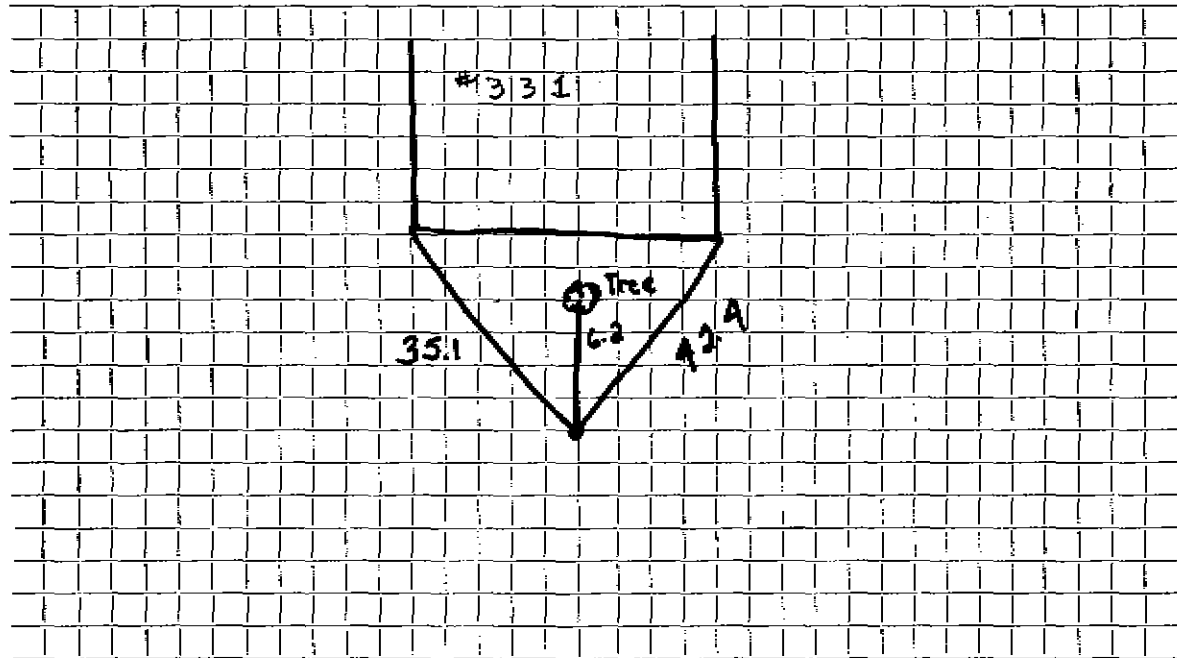

Connection made in *331 Bedford St* Street.

Work completed

Remarks:

.....

.....