

Name

A. Logault

Service No.

88 202

Address

77 Denager Street Arlington
337 Bedford St.

Location

337 Bedford Street # 1941

Kind of Pipe

Size

Size of Main

~~Repair~~ ~~Renewal~~ New Service

Location

Date
1942

Material

Amount

Total

Date

Amount

June 11,
Com 6/22/42

5 hrs. @ 60¢	3	00	
1 " @ 65¢		65	
1 " @ 70¢		70	

10% Overhead

44

42' 1" C.L. Pipe @ 23¢

9 66

1 1" I x 3/4" I.W.H.S. & W.

2 55

1 3/4" x 1 1/2" Bushing

26

1 1" L.L. Coupling

21

1 hr. trucking

75

18 22

Say 18.00

Labor

May 22, 1942 Deposited 18.00

Curb to Main-Not Chargeable		
Labor		31 94
20' 1" C.L. Pipe @ 23¢	4	60
8 3/4" Cop. tubing @ 21¢	1	68
1 3/4" C. Corp. cock	2	25
1 1" I. x 1" I. Curb cock	3	52
1 3/4" C. x 1" I. Union	1	31
1 1" Offset tail piece	1	38
1 1" Straight tail piece	1	38
1 box and rod	1	65
2 hrs. compressor @ 2.25	4	50
1 1/2 hrs. trucking @ 75¢	1	13
4' 3/4 COPPER	53	34
3/4 COP		
1 1" I x 3/4 C Union (2 PART)		

DATE March 31/41

TOWN OF LEXINGTON—BOARD OF PUBLIC WORKS
WATER DIVISION

The undersigned applies for a supply of water at No. 337 Bedford St. and hereby agrees to comply with the rules and regulations as now, or at any future time, established by the Board of Selectmen.

Am't. of Estimate \$ _____

Owner A. Le Gault


Am't. Paid \$ _____

Address 77 Tanager St.

Builder A. Le Gault

Lexington, Mass.

Sketch of Service Here

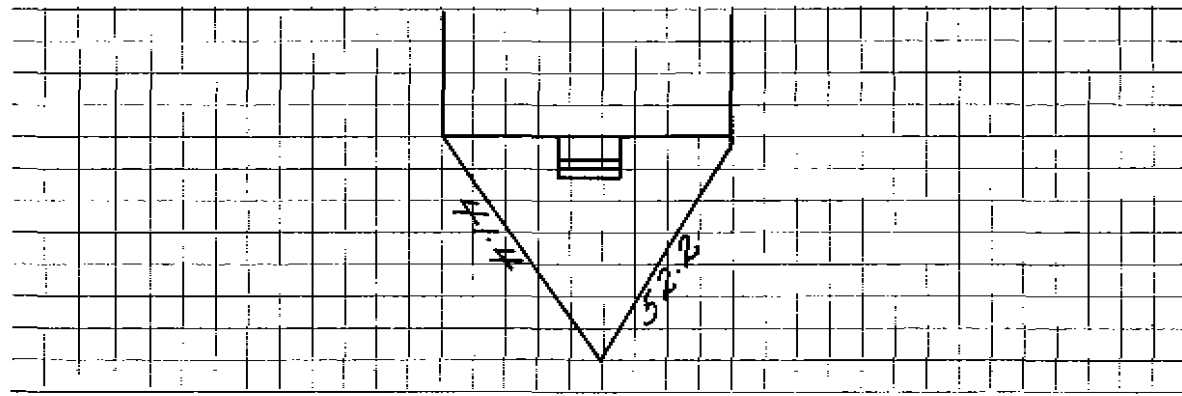

Connection made in _____ Street.

Work completed _____ 19

Remarks: