

Name Henry Harvey
 Address 339 Bedford Street
 Lexington, Mass.

Service No.

Location 339 Bedford Street

Kind of Pipe

Size

Size of Main

~~Repair~~ ~~Renewal~~ ~~New Service~~

Location

Date	Material	Amount	Total	Date	Location	Amount
6/11/42	42' 1" C.L. Pipe				No Charge	
	1 3/4" I x 3/4" ILWLH.S.&W				1 - 3/4" C Corp-cock	3 15
	2 1" L.L. Coupling				4' - 3/4" Copper Tubing @.24	96
	1 1" x 3/4" L.L.Elbow				1 - 3/4" Repair Clamp	1 34
	1 3/4" Close Nipple					5 45
				6/11/42	20' 1" C.L. Pipe	
					8' 3/4" Copper tubing	
					1 3/4" C.Corp. Cock	
					1 1" I x 1" I. Curb Cock	
					1 1" I x 3/4" C.Union	
	Labor					

DATE _____

TOWN OF LEXINGTON - BOARD OF PUBLIC WORKS
WATER DIVISION

The undersigned applies for a supply of water at No..... St. and hereby agrees to comply with the rules and regulations as now, or at any future time, established by the Board of Selectmen.

Am't of Estimate \$.....

Owner


Am't Paid \$.....

Address

Builder

.....

Sketch of Service Here

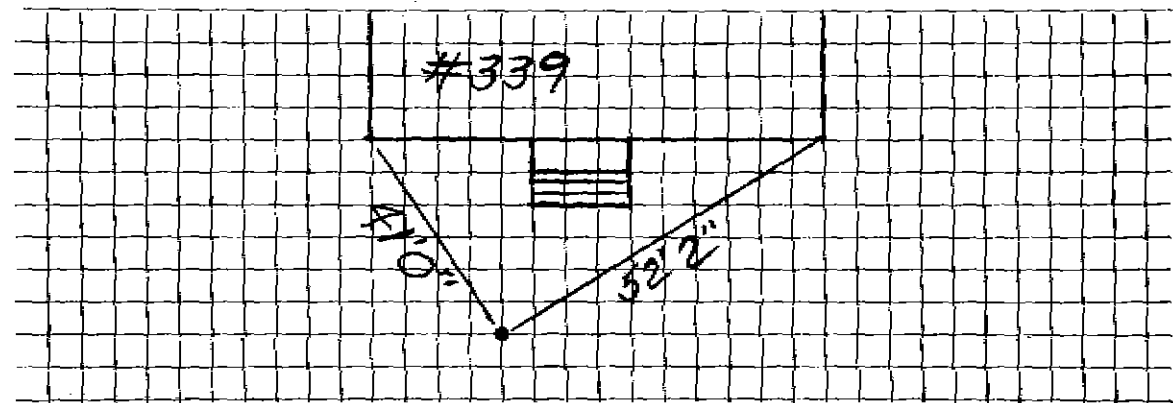

Connection made in Street.

Work completed19

Remarks: