

WATER SERVICE RECORD

Name Outhet Realty Trust

Service No. 137

Address 341 Bedford St.

Location

~~Repair-Renewal~~—New Service

Comm. 11-24-58

Date	Material	Amount	Total	Date	Amount
7/28/58	Labor	3 82		7-15-58	50 00
	10% overhead	38		11-24-58	24 41
			4 20		25 59
	40' 3/4" copper tubing @.37		14 80		
	1 3/4 Cx 1/2 IWH stop & waste		5 84		NON CHARGE
	1 hr. trucking @.75		75		Labor
			25 59		3 22
					30' 3/4" copper tubing @.37
					11 10
					1 3/4" Ccorp cock
					4 64
					1 3/4" C curb cock
					6 03
					1 box & rod
					5 00
					1 1/2 straight tail pc.
					50
					1 1/2 offset tail pc.
					50
					30 99


* Applied to S.M. # 126

DATE _____

TOWN OF LEXINGTON — BOARD OF PUBLIC WORKS

WATER DIVISION

Sketch of Service Here

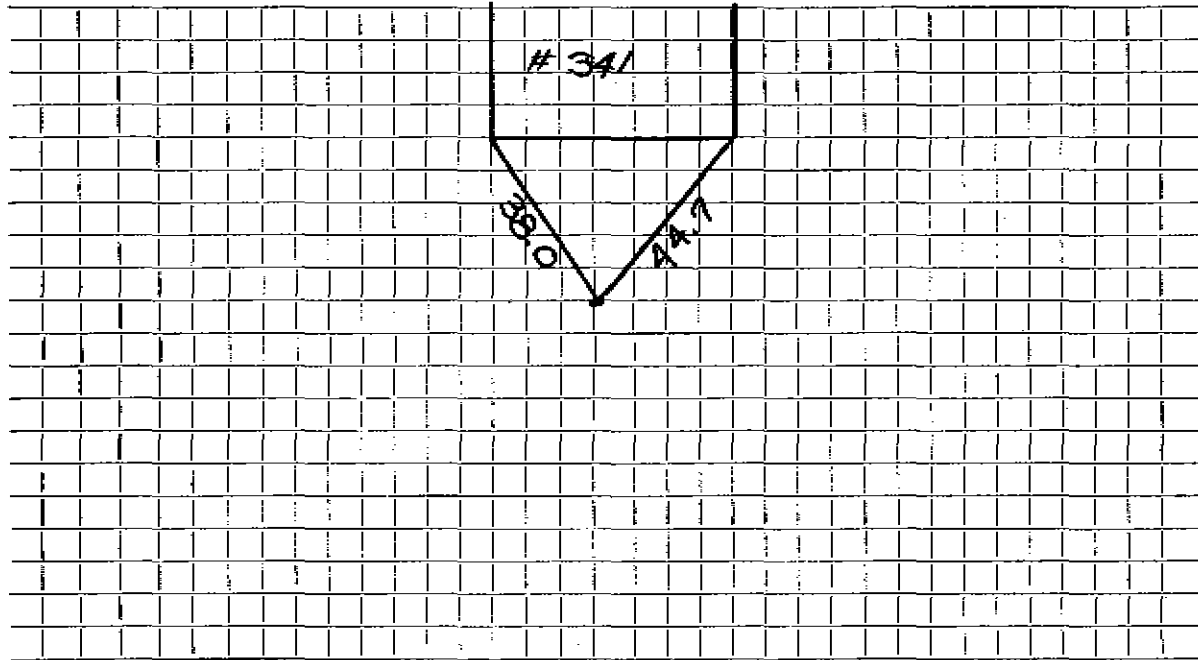

Connection made in Street. Work completed

Remarks:

.....

.....