


DATE _____

TOWN OF LEXINGTON — BOARD OF PUBLIC WORKS
WATER DIVISION

Sketch of Service Here

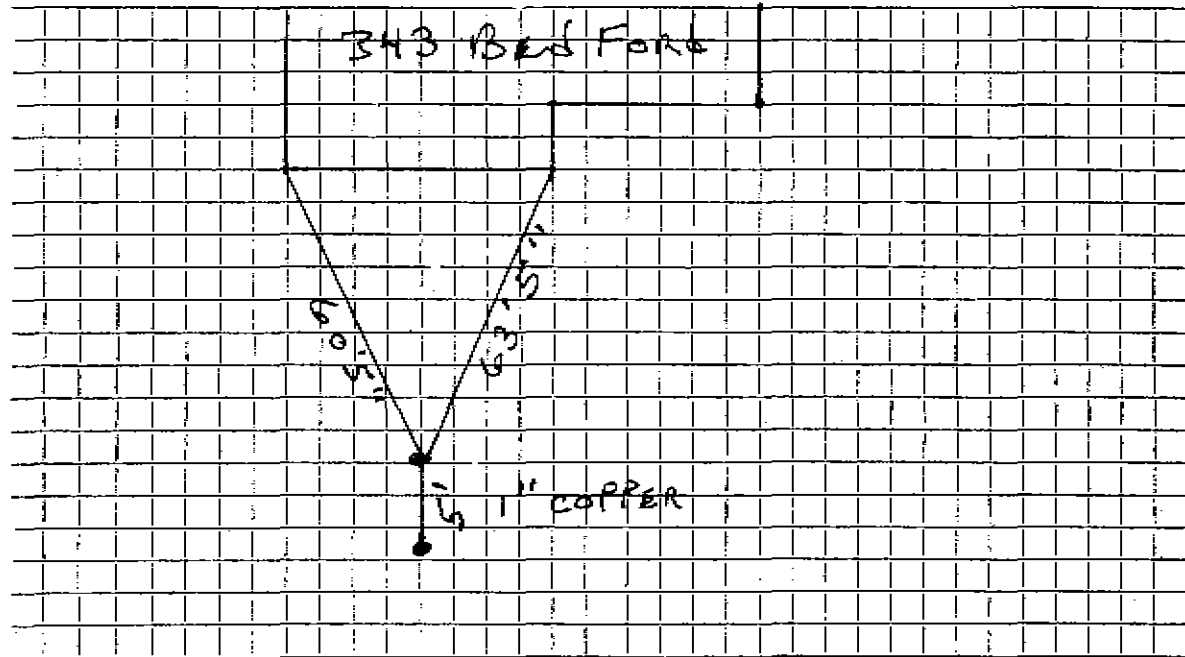

Connection made in Street. Work completed

Remarks: REPAIRED... 2001... NEW CURB... INSTALLED...
SERVICE PUT INTO COPPER 10' FROM CURB 6-7-99