


DATE _____

TOWN OF LEXINGTON — BOARD OF PUBLIC WORKS

WATER DIVISION

Sketch of Service Here

BEDFORD ST.

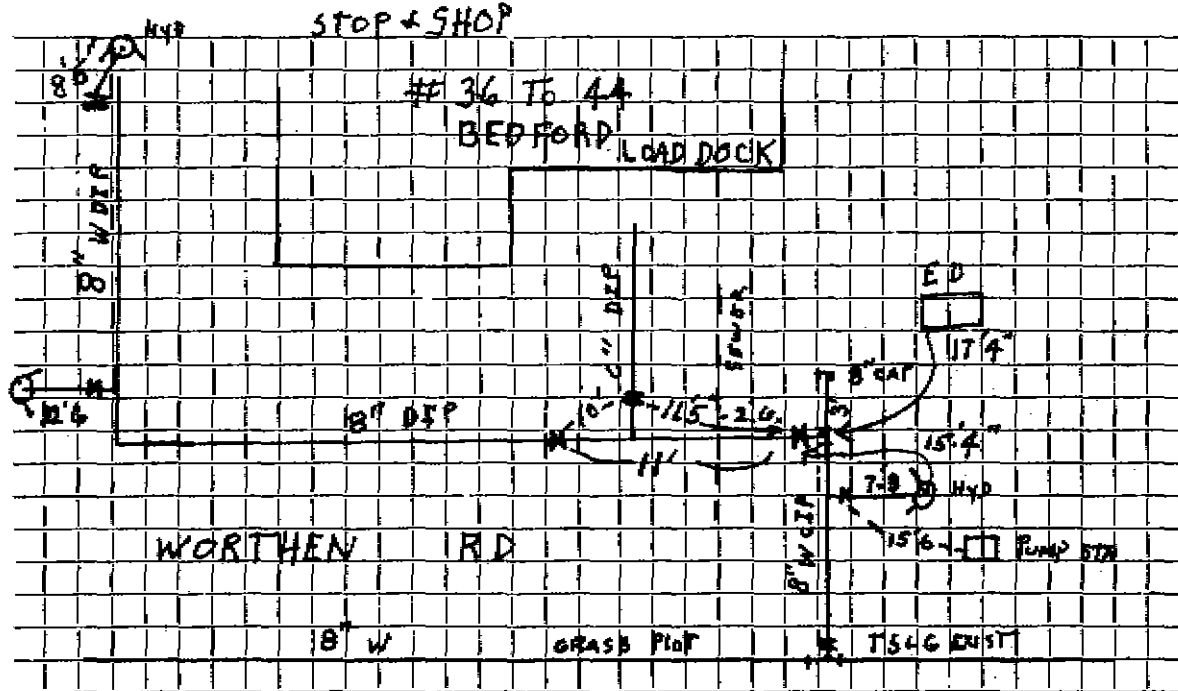

Connection made in Street. Work completed 8/99 - 9/15/99

Remarks: SEWER OVER B"W - IN CEMENT 2.6" FROM TSTG.

S+S CONT. TO GET PLAN TO ENG.