


DATE _____

TOWN OF LEXINGTON - BOARD OF PUBLIC WORKS

WATER DIVISION

Sketch of Service Here

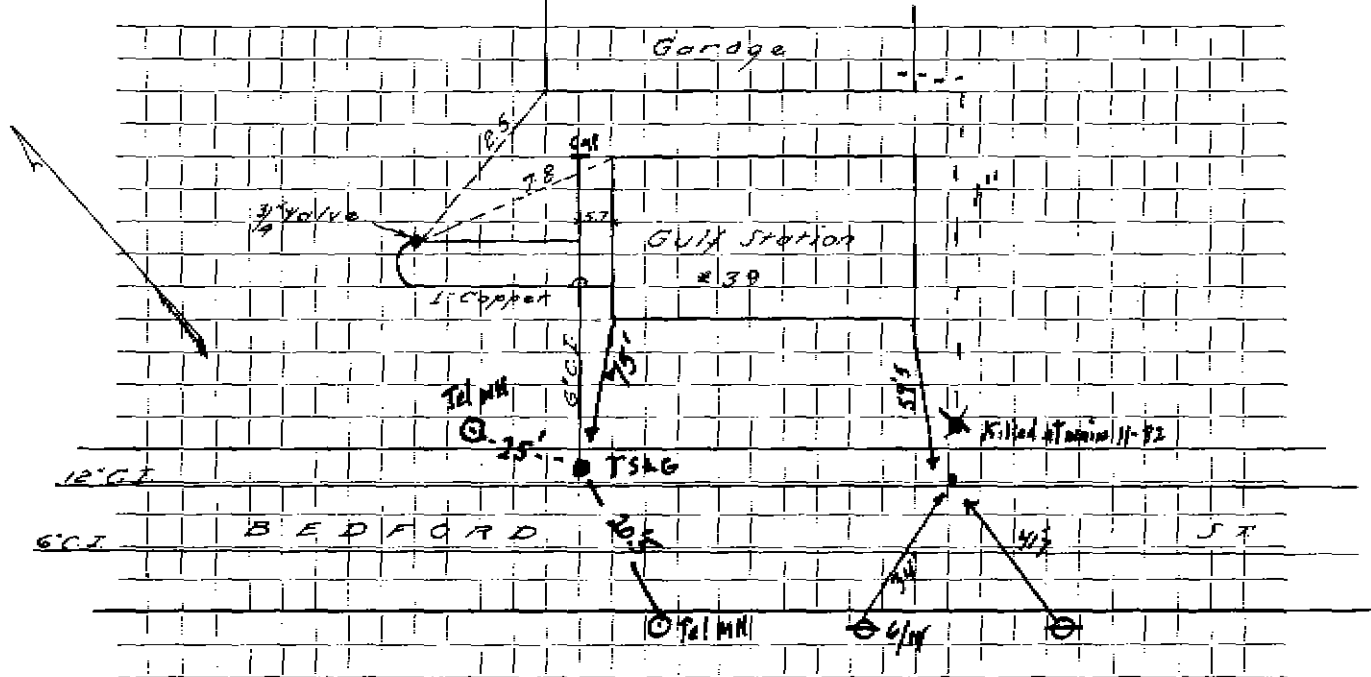

Connection made in Street. Work completed


Remarks: Sprinkler sys. shuts off Gas Sta.

.....
.....

DATE 11/13/00

TOWN OF LEXINGTON — BOARD OF PUBLIC WORKS
WATER DIVISION

Sketch of Service Here

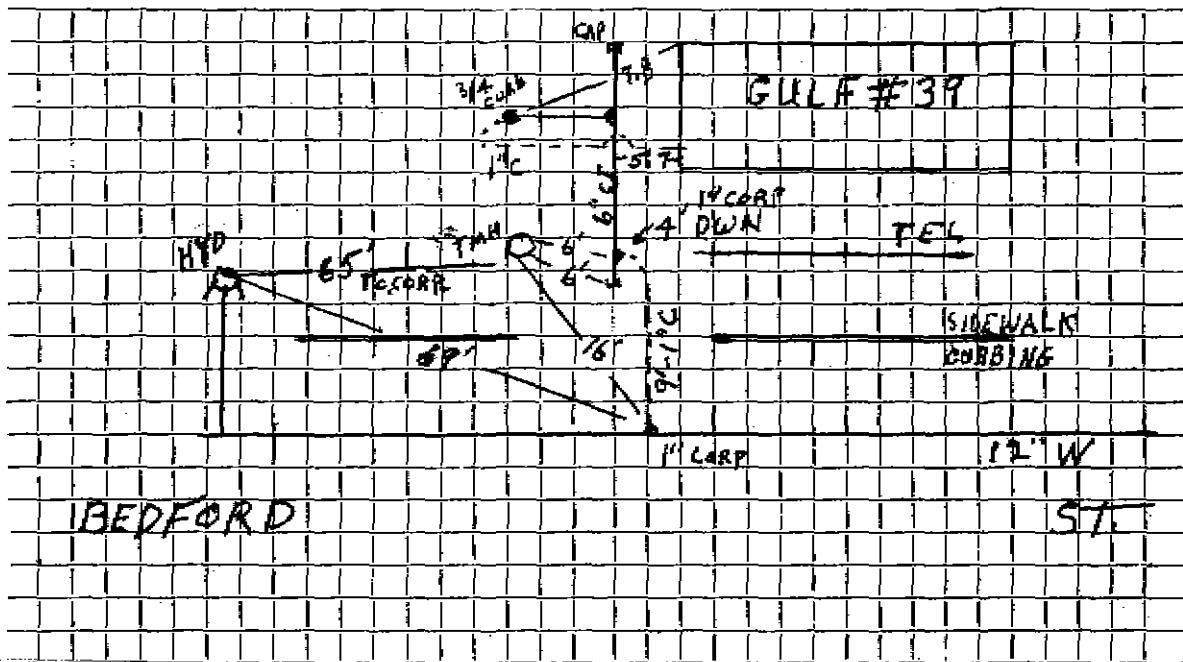

Connection made in Street. Work completed 11-13-00 GRANE SEASON

Remarks: CONTRACTOR WORKING ON GAS STA. OUT SIDE BUILD. LOST 3/4\"/>

3\"/>

6\"/>