

Name Mrs. Bernard Porter.

Service No. 132

Address 411 Bedford Street

2516

Lexington

Location 411 Bedford Street

Kind of Pipe

Size

Size of Main

~~Repair~~ ~~Remove~~ New Service

Com. 9-5-50

Location

| Date | Material | Amount | Total | Date | Amount |
|------------|--------------------------------|--------|-------|-------------------------------|--------|
| July 8 '50 | Labor | 2 55 | | June 14 '50 | 40 00 |
| | 10% Overhead | 26 | 2 81 | | |
| | 34' - 3/4" Copper Tubing @ 23¢ | | 7 82 | | |
| | 1 - 3/4" C x 1/2" I.W.H. S&W | | 3 29 | | |
| | 2 hrs. Littlefield Shovel | | 14 00 | | |
| | 1 hr. Trucking | | 75 | | |
| | | | 28 67 | | |
| | | | | July 8 '50 | 2 55 |
| | | | | | |
| | | | | 9' - 3/4" Copper Tubing @ 23¢ | 2 07 |
| | | | | 1 - 3/4" C. Corp-cock | 3 15 |
| | | | | 1 - 3/4" C x 3/4" C Curb-cock | 3 85 |
| | | | | 1 Box & Rod | 3 35 |
| | | | | 1 - 1/2" Offset Tail Piece | 38 |
| | | | | 1 - 1/2" Straight Tail Piece | 38 |
| | | | | 1 hr. Littlefield Shovel | 7 00 |
| | | | | 1 hr. Trucking | 75 |
| | | | | | 23 48 |

Deposited

No Charge

Hadley Press, Inc., Lexington

DATE _____

TOWN OF LEXINGTON—BOARD OF PUBLIC WORKS

WATER DIVISION

The undersigned applies for a supply of water at No. _____ St. and hereby agrees to comply with the rules and regulations as now, or at any future time, established by the Board of Selectmen.

Am't. of Estimate \$ _____


Owner _____

Am't. Paid \$ _____

Address _____

Builder _____

Sketch of Service Here

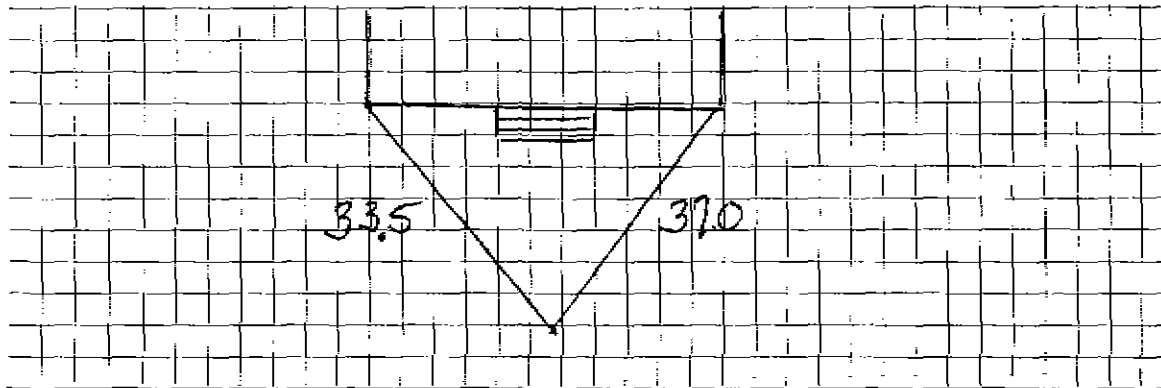

Connection made in _____ Street.

Work completed _____ 19

Remarks: