

WATER SERVICE RECORD

Name _____

Service No. _____

Address _____

Location **413 BEDFORD ST**

Repair—Renewal—New Service _____


Date	Material	Amount	Total	Date	OUTSIDE	Amount
7/31/28	39' 3/4" CL PIPE			?	3/4" COPPER	
					3/4" COP	
					3/4" CURB	
				10/2/76	Buffalo Box	
					2' 3/4" COPPER	
					1" Iron x 3/4" COPPER	
					1" FX 3/4" C	

DATE _____

TOWN OF LEXINGTON — BOARD OF PUBLIC WORKS

WATER DIVISION

Sketch of Service Here

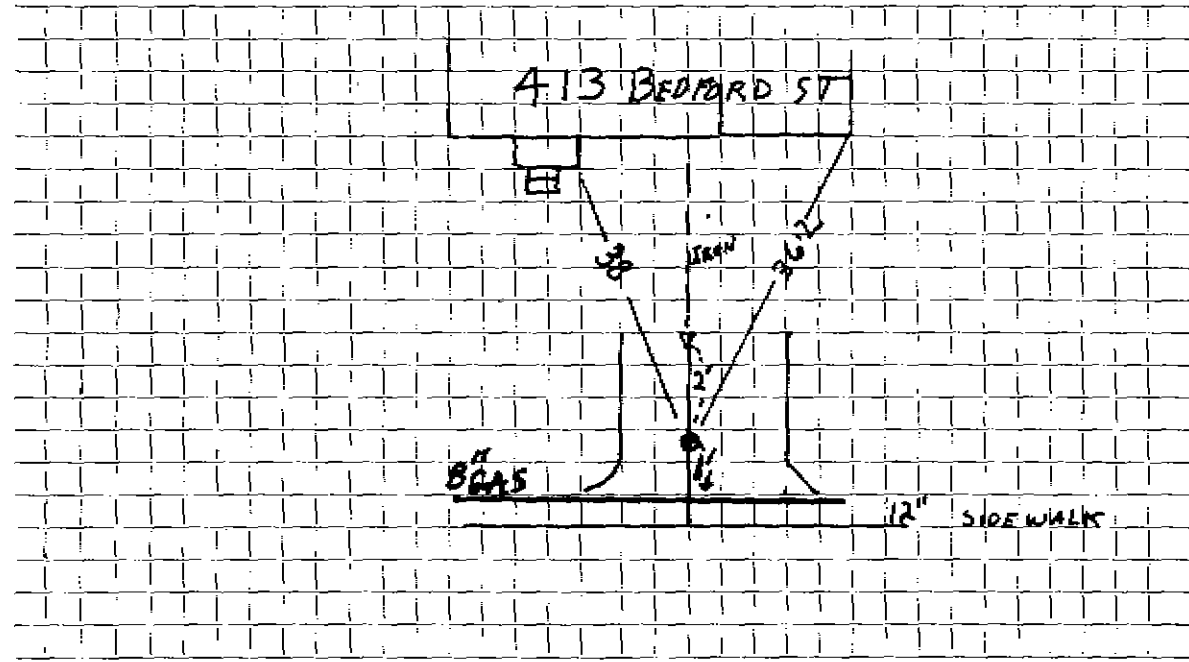

Connection made in 12" MAIN Street. Work completed

Remarks: BIG BOULDER HOUSE SIDE OF IRON CONNECTION (IT MOVED) COPPER IS 2' BELOW BOTTOM OF BOULDER