

Name Margaret M. Long
 Address 415 Bedford Street
 Lexington, Mass.

Service No.

2802

Location 415 Bedford Street

Kind of Pipe

Size

Size of Main

~~Repair~~ ~~Renewal~~ New Service

Com. 11-8-49

Location

Date	Material	Amount	Total	Date	Amount
Sept. 30, '49	Labor	5 00	5 00	Sept 28 '49	65 00
	10% Overhead		50	7-12-49	
	31' - 3/4" Copper Tubing @.24		7 44		23 98
	1 - 3/4" C x 1/2" F.W.H. S&W		3 29	Sept. 30, '49	6 90
	Littlefield Shovel 1 hr. @ 7.00	7 00	7 00	10' - 3/4" Copper Tubing @.24	2 40
	Trucking 1 hr. @ .75		75	1 - 3/4" C Corp-cock	3 15
			23 98	1 - 3/4" C x 3/4" C Curb-cock	3 85
				1 - Box & Rod	3 75
				1 - 1/2" Offset Tail Piece	37
				1 - 1/2" Straight Tail Piece	37
				Littlefield Shovel 1 hr. @ 7.00	7 00
				Trucking 1 hr. @ .75	75
	Labor				28 54

Deposited
(S. Brown)
 No Charge

9-13-65 WATER PIPE IN WAY

DATE _____

TOWN OF LEXINGTON - BOARD OF PUBLIC WORKS

WATER DIVISION

The undersigned applies for a supply of water at No..... St. and hereby agrees to comply with the rules and regulations as now, or at any future time, established by the Board of Selectmen.

Am't of Estimate \$.....

Owner


Am't Paid \$.....

Address

Builder

.....

Sketch of Service Here

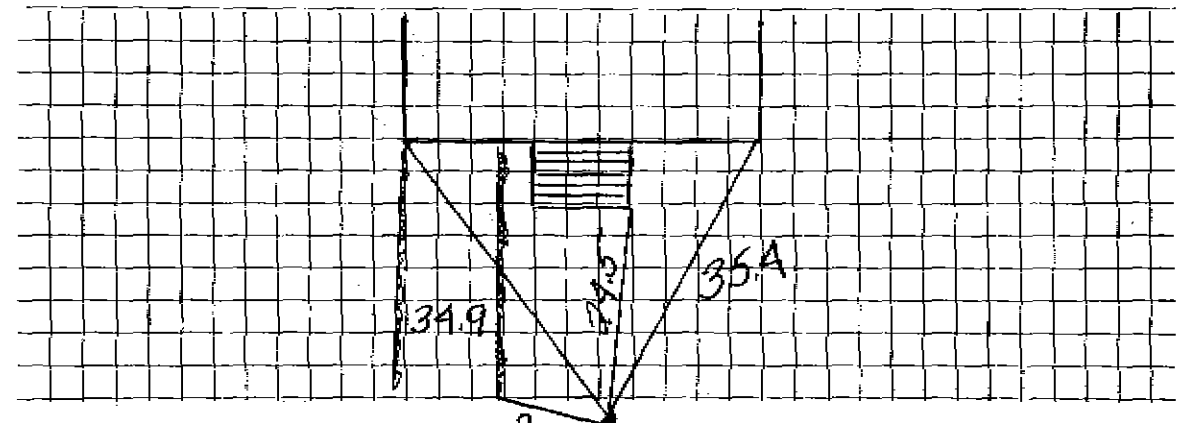

Connection made in 7 Street.

Work completed19

Remarks: