

Name

Service No. 219

Address 419 Bedford St.

Location 419 Bedford St.

Kind of Pipe

Size

Size of Main

Repair—Renewal—New Service

Location

Date

Material

Amount

Total

Date

Amount

Labor

DATE _____

TOWN OF LEXINGTON—BOARD OF PUBLIC WORKS WATER DIVISION

The undersigned applies for a supply of water at No. _____ St. and hereby agrees to comply with the rules and regulations as now, or at any future time, established by the Board of Selectmen.

Am't. of Estimate \$ _____

Owner

J. Smith


Am't. Paid \$ _____

Address

412 Bedford St.

Builder _____

Sketch of Service Here

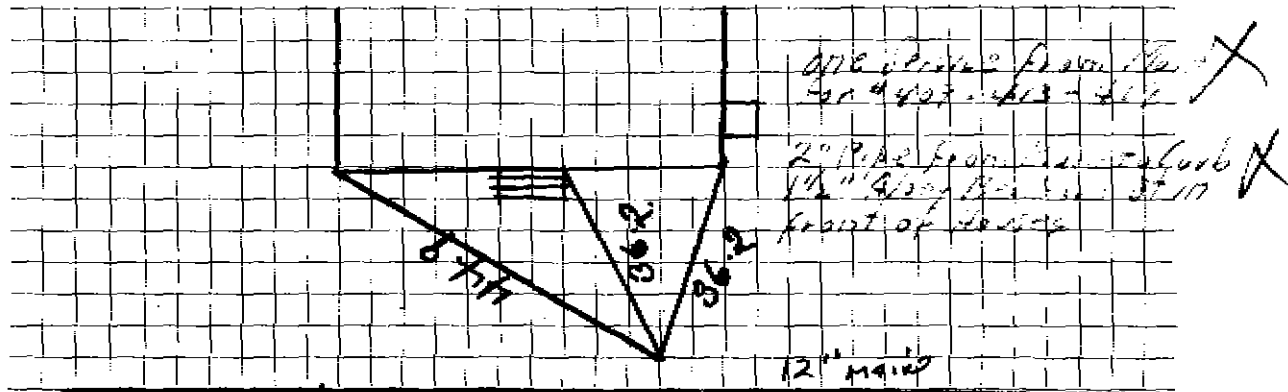

Connection made in Bedford 12" main Street. St

Work completed _____ 19

Remarks: