

WATER SERVICE RECORD

#789
85

Name MacLand Incorporated

Service No.

Address 421 Bedford Street

Location Lexington, Mass.

~~Repair~~ ~~General~~ New Service


Com. 8-6-51

Date	Material	Amount	Total	Date	Material	Amount
5-28-51	Labor	1 65	1 65	May 14 51	Repaired	11 00
	10% Overhead		17	8-9-51	Repaired	4 43
	1 - 3/4" C x 1/2" I.W.F. S&W		4 00		No Charge	6 57
	Trucking 1 hr. @ .75		75	5-28-51	Labor	6 36
			6 57	5' - 3/4" Copper Tubing @ .326		1 63
				1 - 3/4" C Corp-cock		4 33
	Pipe supplied by owner			1 - 3/4" C x 3/4" Curb-cock		4 67
	Trench dug by owner			1 - Box & Rod		4 68
				1 - 1/2" Offset Tail Piece		50
				1 - 1/2" Straight Tail Piece		50
				Box Shovel 1 hr. @ 9.00		9 00
				Trucking 1 hr. @ .75		75
						32 42

DATE _____

TOWN OF LEXINGTON — BOARD OF PUBLIC WORKS
WATER DIVISION

Sketch of Service Here

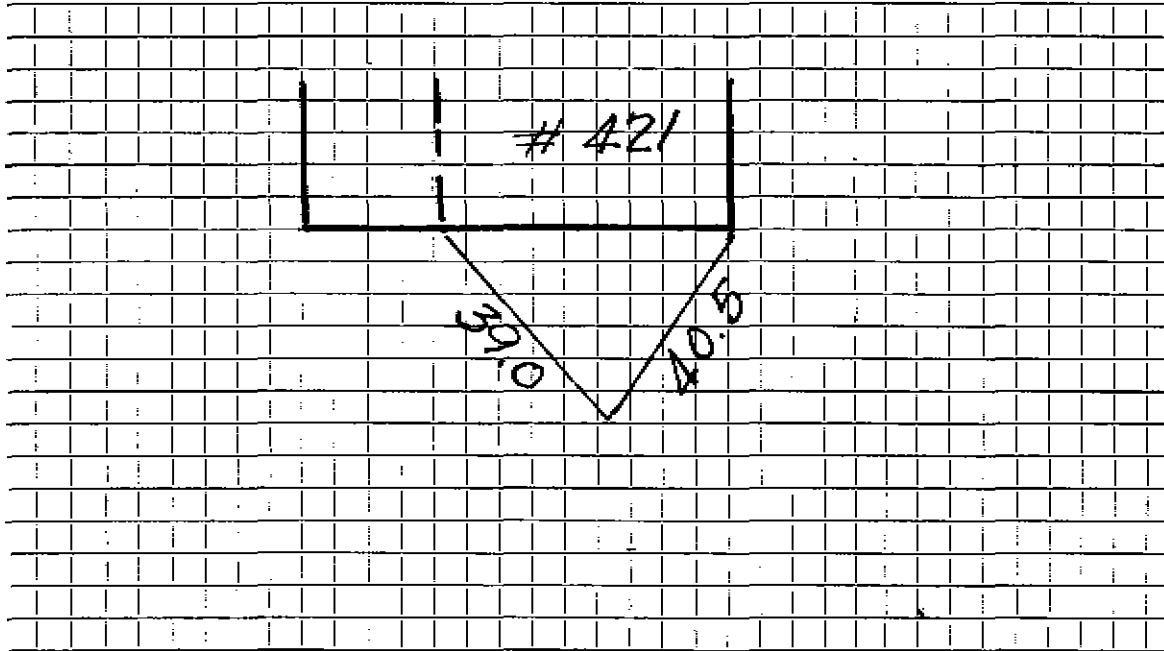

Connection made in Street. Work completed

Remarks:

.....
.....