

WATER SERVICE RECORD

#3341

Name MacLand Incorporated

Service No. 85

Address 423 Bedford Street

Location Lexington, Mass.

Repair x Renovate - New Service


Com. 8-6-51

Date	Material	Amount	Total	Date		Amount
5-28-51	Labor	1.65	1.65	May 14 '51	Deposited	11.00
	10% Overhead		17	May 14 '51	Deposited	1.70
	1 - 3/4" C x 1/2" I. W.H. SAW	1.00			No Charge	1.00
	Trucking 1 hr. @ .75		.75	5-28-51	Labor	6.36
			6.57		5' - 3/4" Copper Tubing @ .326	1.63
	Pipe supplied by owner				1 - 3/4" Corp-cock	4.33
	Trench dug by owner				1 - 3/4" C x 3/4" C Curb-cock	4.67
					1 - Box & Rod	4.68
					1 - 1/2" Offset Tail Piece	.50
					1 - 1/2" Straight Tail Piece	.50
					Brix Shovel 1 hr. @ 9.00	9.00
					Trucking 1 hr. @ .75	.75
						32.42

DATE _____

TOWN OF LEXINGTON — BOARD OF PUBLIC WORKS
WATER DIVISION

Sketch of Service Here

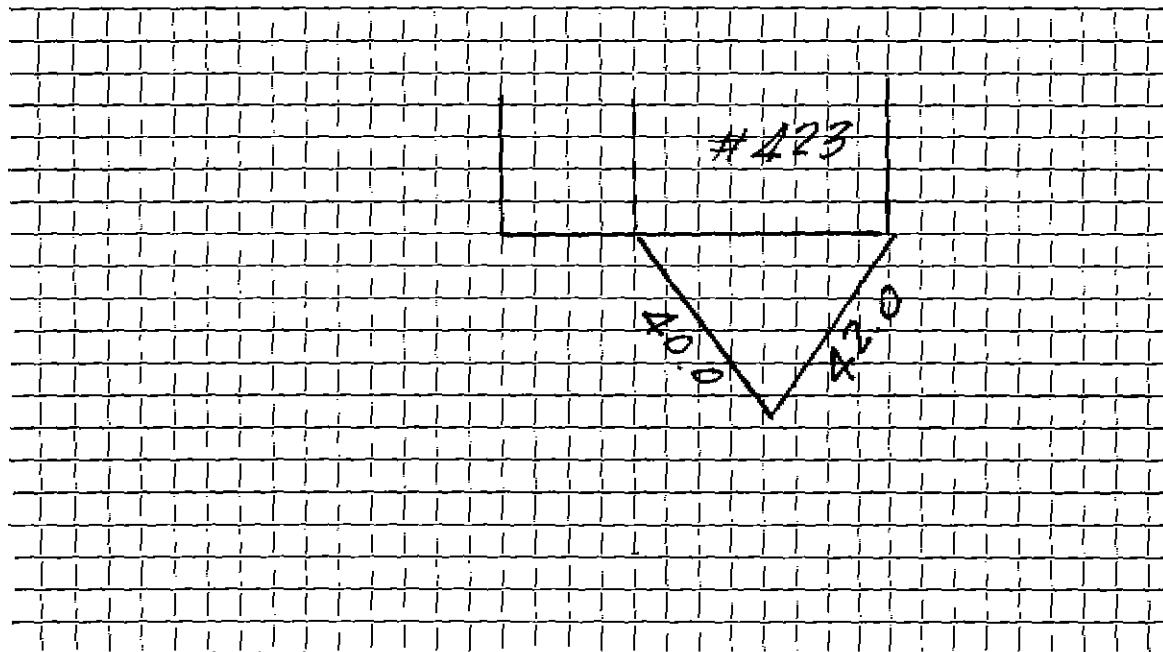

Connection made in Street. Work completed

Remarks: