

Name Raymond Turcott
 Address 424 Bedford Street
 Lexington, Mass.

Service No. 3259/1 ✓

Location 424 Bedford Street

Kind of Pipe

Size

Size of Main

~~Repair~~ ~~Renewal~~ — New Service

Location

Date	Material	Amount	Total	Date	Location	Amount
May 14, '47	Labor	1 05	1 05	May 14, '47	Labor	17 52
	10% Overhead		11	May 15, '47	"	4 43
	62' - 3/4" Copper Tubing @.27	16 74	3 15	May 14, '47	7' - 3/4" Copper Tubing @.27	1 39
	1 - 3/4" C x 1/2" I.W.F. S & W	3 15	1 32		1 - 3/4" C Corp-cock	3 00
	1 - 3/4" C x 3/4" C Union (3pts)	1 32	75		1 - 3/4" C x 3/4" C Curb-cock	3 68
	Trucking 1 hr. @.75		23 12		1 - Box & Rod	4 26
					1 - 1/2" Straight Tail Piece	30
					1 - 3/8" Offset Tail Piece	30
					Trucking 1 hr. @.75	75
	Labor					36 13

Deposited
Refunded
 Non-Charge

80 00
 6 88
 23 12

DATE _____

TOWN OF LEXINGTON - BOARD OF PUBLIC WORKS

WATER DIVISION

The undersigned applies for a supply of water at No. St. and hereby agrees to comply with the rules and regulations as now, or at any future time, established by the Board of Selectmen.

Am't of Estimate \$.....


Owner

Am't Paid \$.....

Address

Builder

Sketch of Service Here

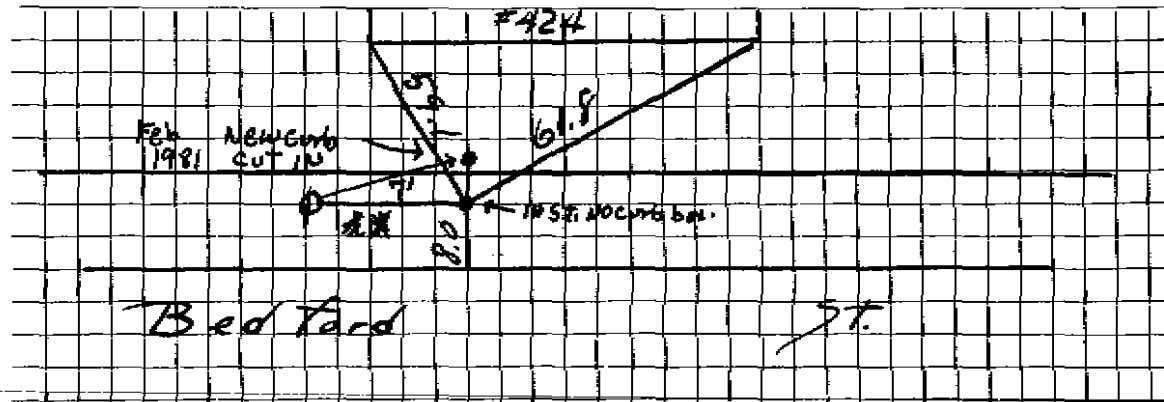

Connection made in Street.

Work completed19

Remarks: