

WATER SERVICE RECORD

Name MacLand Incorporated

Service No. 85

Address 425 Bedford Street

# 705

Location Lexington, Mass.

# 734

~~Repair~~ ~~Renewal~~ New Service


Com. 8-6-51

Date	Material	Amount	Total	Date	Amount
5-28-51	Labor	1 65	1 65	May 14 '51	11 00
	10% Overhead		17		4 42
	1 - 3/4" C x 1/8" I.W.F. S&W		4 00		No Charge
	Trucking 1 hr. @ .75		75	5-28-51	6 36
			6 57	5' - 3/4" Copper Tubing @ .326	1 63
	Pipe supplied by owner			1 - 3/4" C Corp-cock	4 33
	Trench dug by owner			1 - 3/4" C x 3/4" Curb-cock	4 67
				1 - Box α Rod	4 68
				1 - 1/2" Offset Tail Piece	50
				1 - 1/2" Straight Tail Piece	50
				Brox Shovel 1 hr. @ 9.00	9 00
				Trucking 1 hr. @ .75	75
					32 42

DATE \_\_\_\_\_

**TOWN OF LEXINGTON — BOARD OF PUBLIC WORKS**  
**WATER DIVISION**

Sketch of Service Here

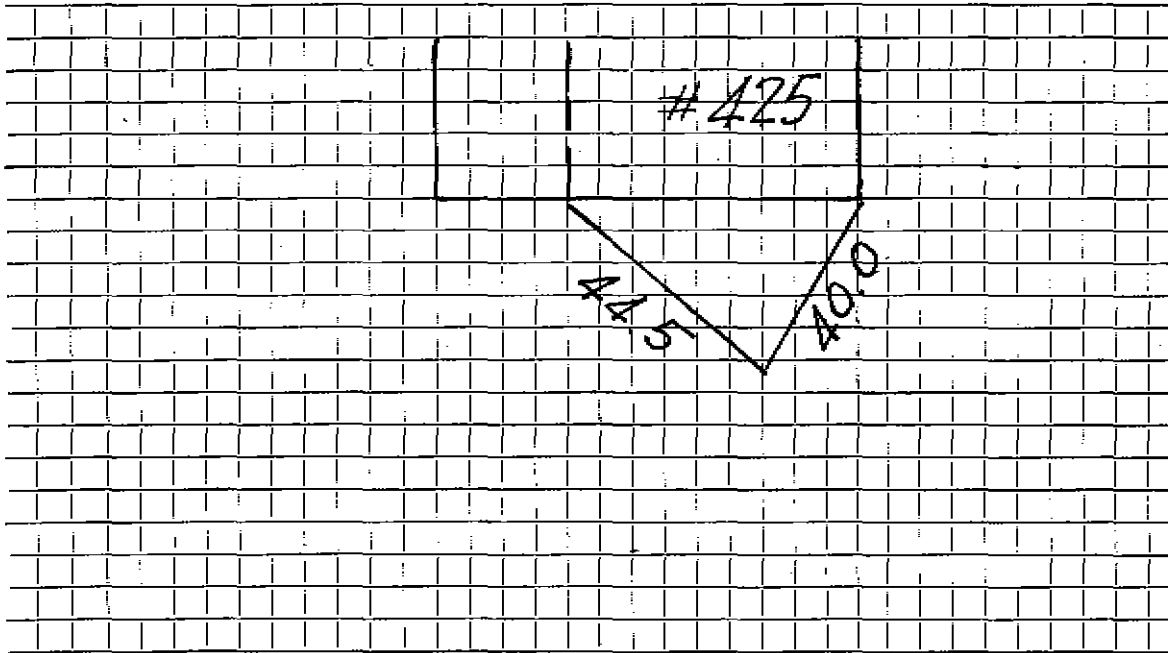

Connection made in ..... Street. Work completed .....

Remarks: .....  
.....  
.....