

WATER SERVICE RECORD

Name

Service No.

Address

Location 433 Bedford Street

~~Repair~~ - Renewal - ~~New Service~~ W.O. #961


Date	Material	Amount	Total	Date	INSIDE	Amount
6-21-'73	Labor	\$97.84		9/9/36	45' 1" CLP.	
7-20-'73	Labor	39.69	\$137.53			
	8' 3/4" Copper Pipe					
	1 3/4" Corp					
	1 3/4" Curb Cock					
	1/2 Yd. Loam					
	1/2 lb. Grass Seed					
	4Yds. Gravel					
	1 Box & Rod					
	1/2 Ton Top					
	3 Hrs. Trucking					
	1/2 Hr. Pickup					
	1/2 Hr. Roller					
	1/2 Hr. Compressor					
	1/2 Hr. Loader					
	2 Hrs. Town Shovel					

DATE _____

TOWN OF LEXINGTON — BOARD OF PUBLIC WORKS

WATER DIVISION

Sketch of Service Here

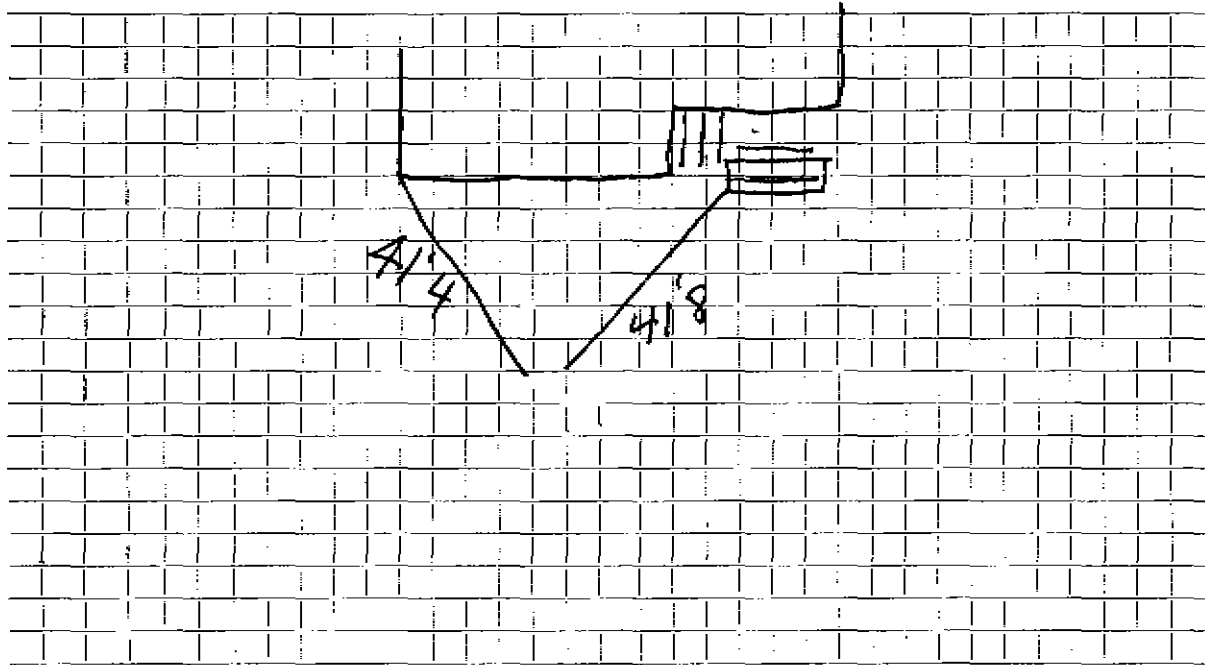

Connection made in Street. Work completed

Remarks:
.....
.....