

WATER SERVICE RECORD

Name Richard H. Soule

Service No. 113

Address 435 Bedford Street

Location

Repair: ~~Renewal~~ - New Service

*Com. 8-15-55*


Date	Material	Amount	Total	Date	Amount
6/18/55	Labor	1 85		7-27-55	75 04
	10% Overhead	19	2 04	8-15-55	42 49
	65' - 3/4" Copper tubing @ .3693	24 00			NON CHARGE
	1 - 3/4" C x 1/2" I.W.H. stop & waste	4 00		6/18/58	Labor
	1 - 3/4" C x 3/4" C. Union 3 pts	1 72			2' - 3/4" Copper tubing @ .3693
	1 hr. trucking		75		1 - 3/4" C. corp-cock
			32 51		1 - 3/4" c. x 3/4" C. curb-cock
					1 box sand rod
					1 - 1/2" offset tail piece
					1 - 1/2" straight tail piece
					1 hr. trucking
					17 24

DATE \_\_\_\_\_

TOWN OF LEXINGTON — BOARD OF PUBLIC WORKS

WATER DIVISION

Sketch of Service Here

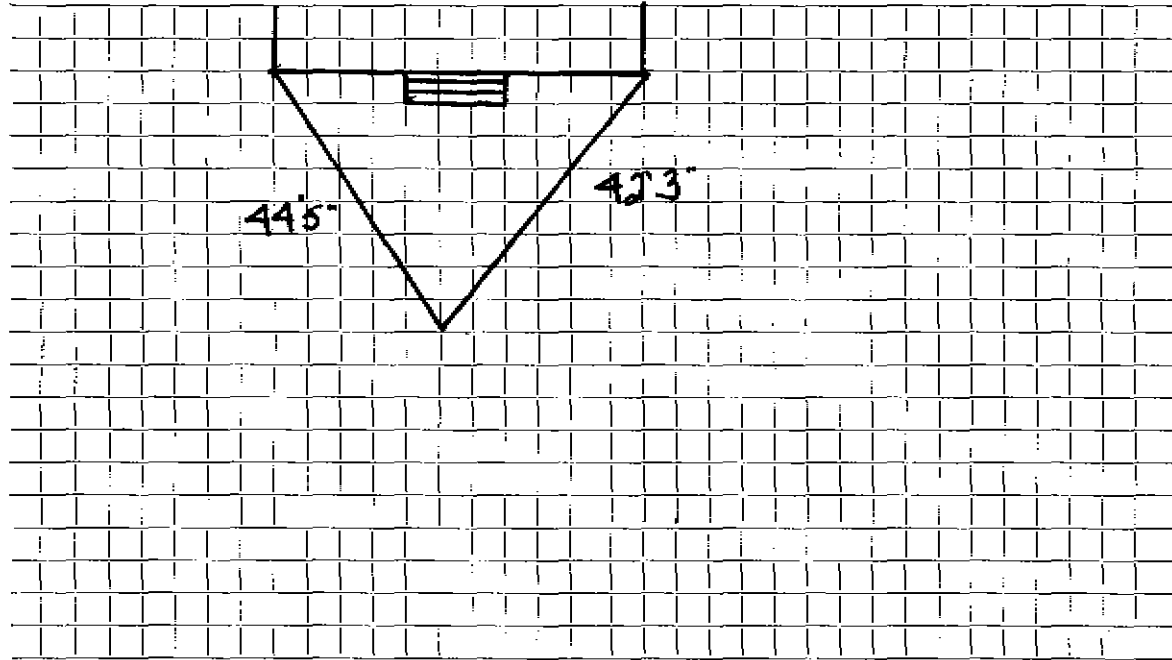

Connection made in ..... Street. Work completed .....

Remarks: .....  
.....  
.....