

2766

Name Richard H. Soule

WATER SERVICE RECORD

Service No.

115

Address 439 Bedford Street

Location

Repair-Renewal—New Service

Conn. 8-15-55


Date	Material	Amount	Total	Date	Amount
6/20/55	Labor	1 85		4-27-55 Deposited	75 00
	10% Overhead	19	2 04	8-15-55 Refunded	(675 10)
	85' - 3/4" Copper tubing @ .3693	31 39			<u>39 90</u>
	1 - 3/4" C x 1/2" I.W.H. stop & waste	4 08	6/20/55 Labor		1 85
	1 - 3/4" C x 3/4" C. Union	3 pts 1 72	2' - 3/4" Copper tubing @ .3693		74
	1 hr. trucking		75	1 - 3/4" C. corp-cock	4 33
			<u>39 90</u>	1 - 3/4" C x 3/4" C. curb-cock	4 67
				1 box and rod	3 90
				1 - 1/2" offset tail piece	50
				1 - 1/2" straight tail piece	50
				1 hr. trucking	<u>75</u>
					17 24

DATE _____

TOWN OF LEXINGTON — BOARD OF PUBLIC WORKS

WATER DIVISION

Sketch of Service Here

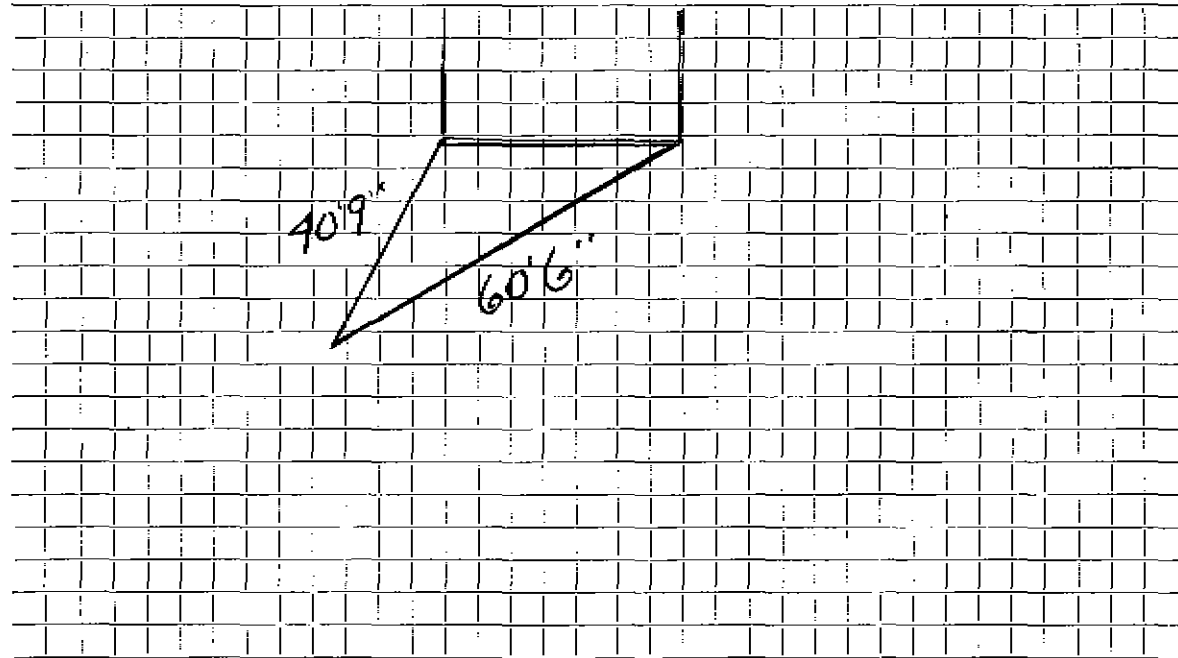

Connection made in Street. Work completed

Remarks:
.....
.....