


DATE _____

TOWN OF LEXINGTON — BOARD OF PUBLIC WORKS

WATER DIVISION

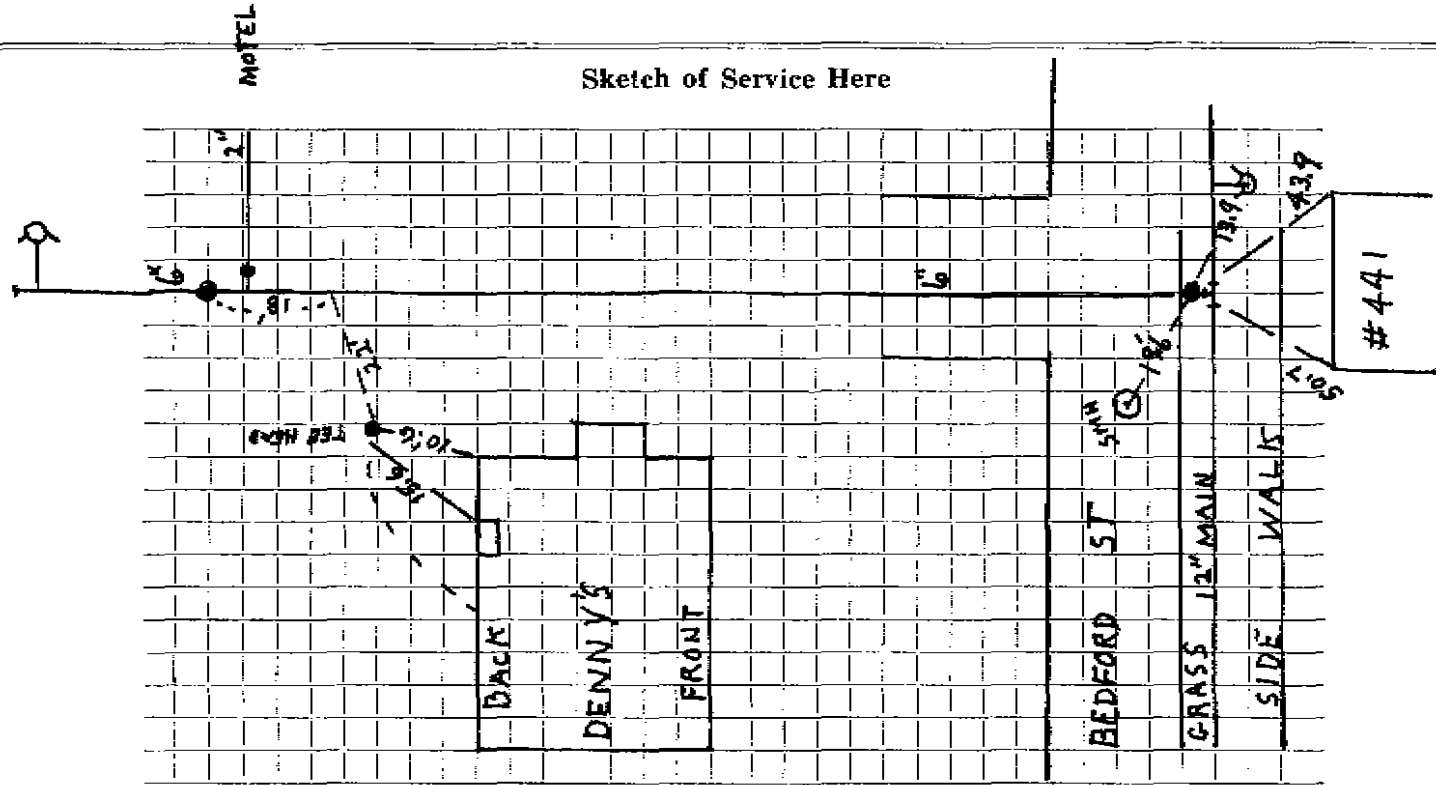

Connection made in Street. Work completed

Remarks:

.....

.....


DATE MARCH 26, 1997

TOWN OF LEXINGTON — BOARD OF PUBLIC WORKS

WATER DIVISION

*SEE PREVIOUS TIE CARDS.

Sketch of Service Here

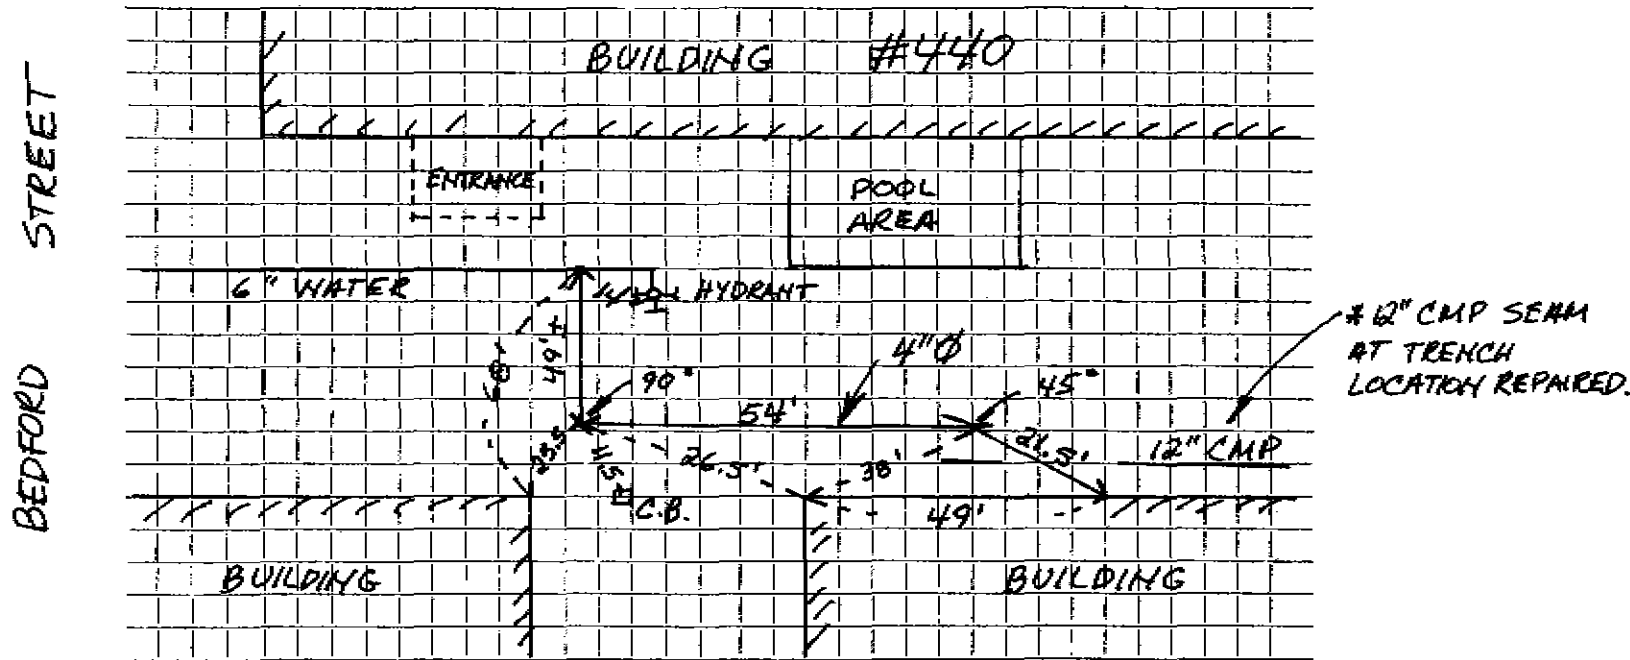

Connection made in _____ Street. Work completed _____

Remarks: 4" Ø WATER SERVICE INSTALLED FOR SPRINKLER SYSTEM.

WATER SERVICE RECORD

Name **Chalet Suisse International, Inc.**

Service No. **5**

Address **440 Bedford Street 2 SERVICE CARDS**

Location

Repair—Renewal—New Service **100 # 7420 McGovern Const. #1623**

NOV 23 1970

Date	Material	Amount	Total	Date	Amount
6/29/70	Labor	144.64		4-1-70	500.00
6/30/70	"	162.20		9-3-71	119.14
7/2/70	"	52.32			619.14
7/22/70	"	29.03			
		388.19			
	10% O.H.	38.82	427.01		
9'	6" Water pipe @ 2.10		18.90		
1	6" Offset		77.75		
1/2	Ton Cold Patch @ 6.00		3.00		
6	hrs. Trucking @ 3.00		18.00		
8	hrs. Shovel @ 6.50		52.00		
4 1/2	hrs. Compressor @ 5.00		22.50		
			619.16		
7/17/70	323' 6" Cast Iron Pipe 12x6 T.S.-GATE				


Bill 500.00 119.14

DATE _____

TOWN OF LEXINGTON -- BOARD OF PUBLIC WORKS

WATER DIVISION

Sketch of Service Here

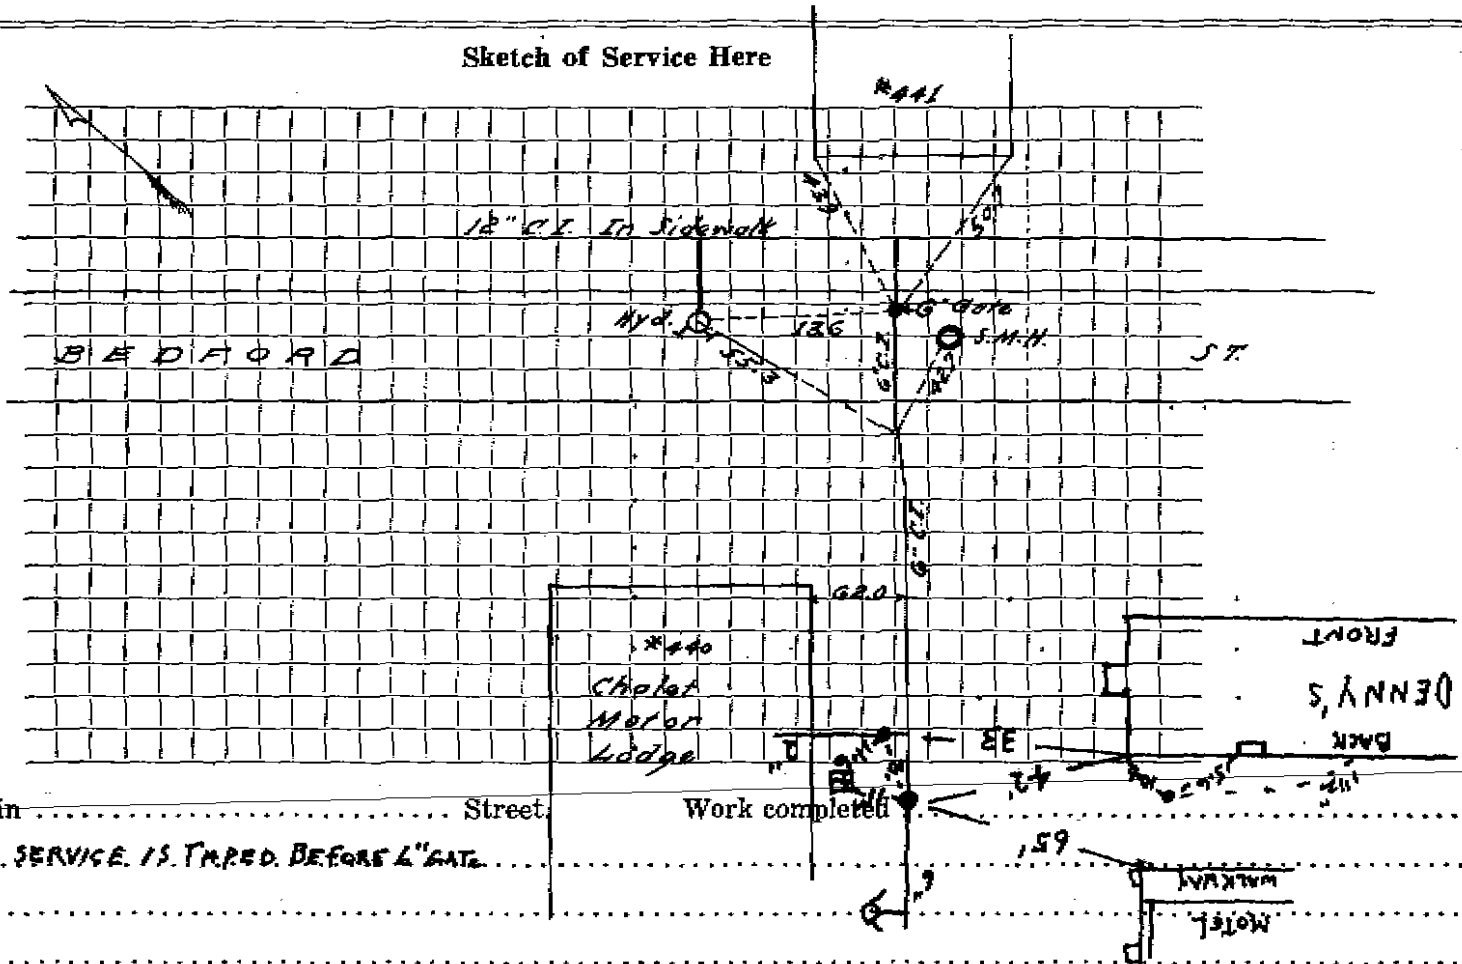

Connection made in _____ Street.

Remarks: DENNY'S SERVICE IS TAPPED BEFORE 6" GATE.