

WATER SERVICE RECORD

Name Ralph J. Frissore

Service No. 174

Address 441 Bedford Street

Location

Repair, Renewal, New Service

*Conn. 8-15-55*

Date	Material	Amount	Total	Date	Amount
6/20/55	Labor	1 85		6-7-55	75 00
	10% Overhead	19	2 04	8-15-55	42 49
	65' - 3/4" Copper tubing @ .3693	24 00			82 51
	1 - 3/4" C x 1/2" I.W.H. stop & waste	4 00		6/20/55	Labor
	1 - 3/4" C x 3/4" C. Union	3 72			1 85
	1 hr. trucking		75		74
			32 51		4 33
					4 67
					3 90
					50
					50
					75
					17 24


*Deposited*  
*Refunded*  
NON CHARGE

DATE \_\_\_\_\_

TOWN OF LEXINGTON — BOARD OF PUBLIC WORKS

**WATER DIVISION**

Sketch of Service Here

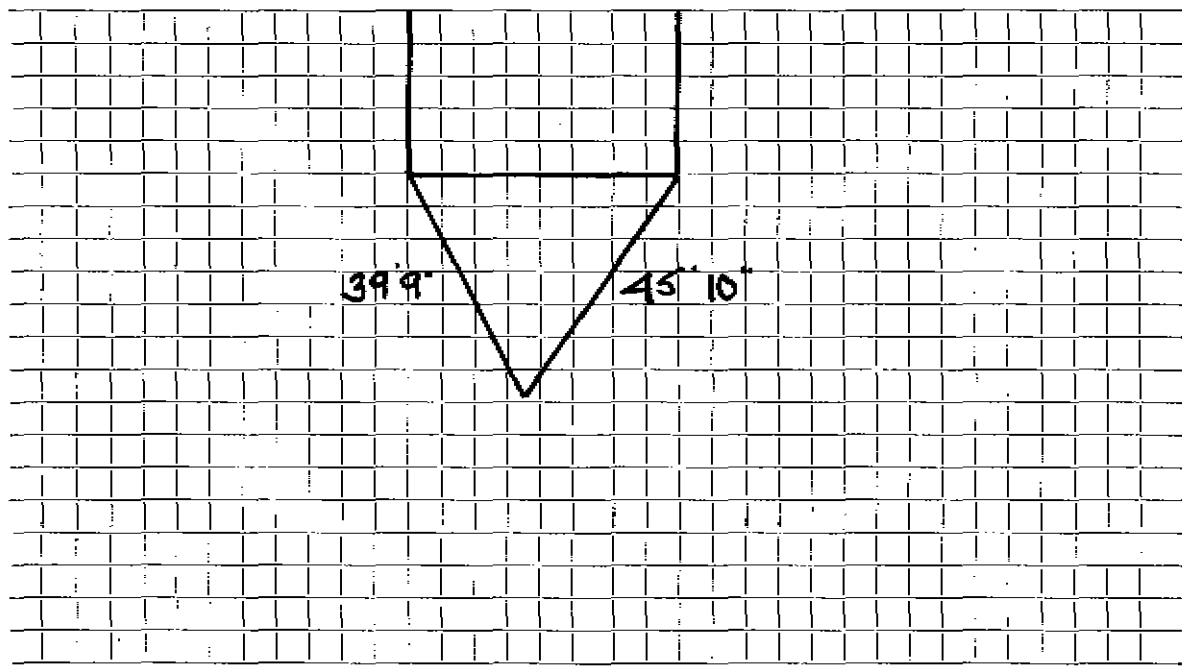

Connection made in ..... Street. Work completed .....

Remarks: .....  
.....  
.....