

TOWN OF LEXINGTON — BOARD OF PUBLIC WORKS

WATER DIVISION

DATE _____

Across ST. FROM
WASSE #991

5 M.H.

W.S. FOR #492


Sketch of Service Here

Hyd. D.

692

571

STA. 2810 I

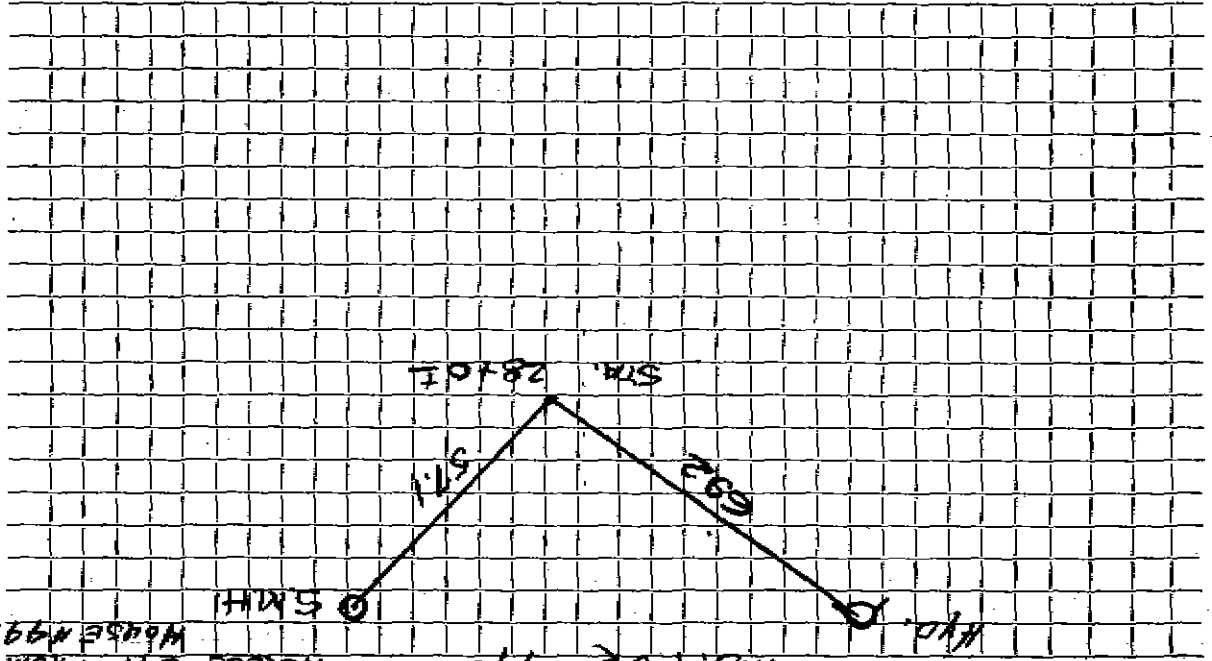

Connection made in _____

Street _____

Work completed _____

Remarks: _____